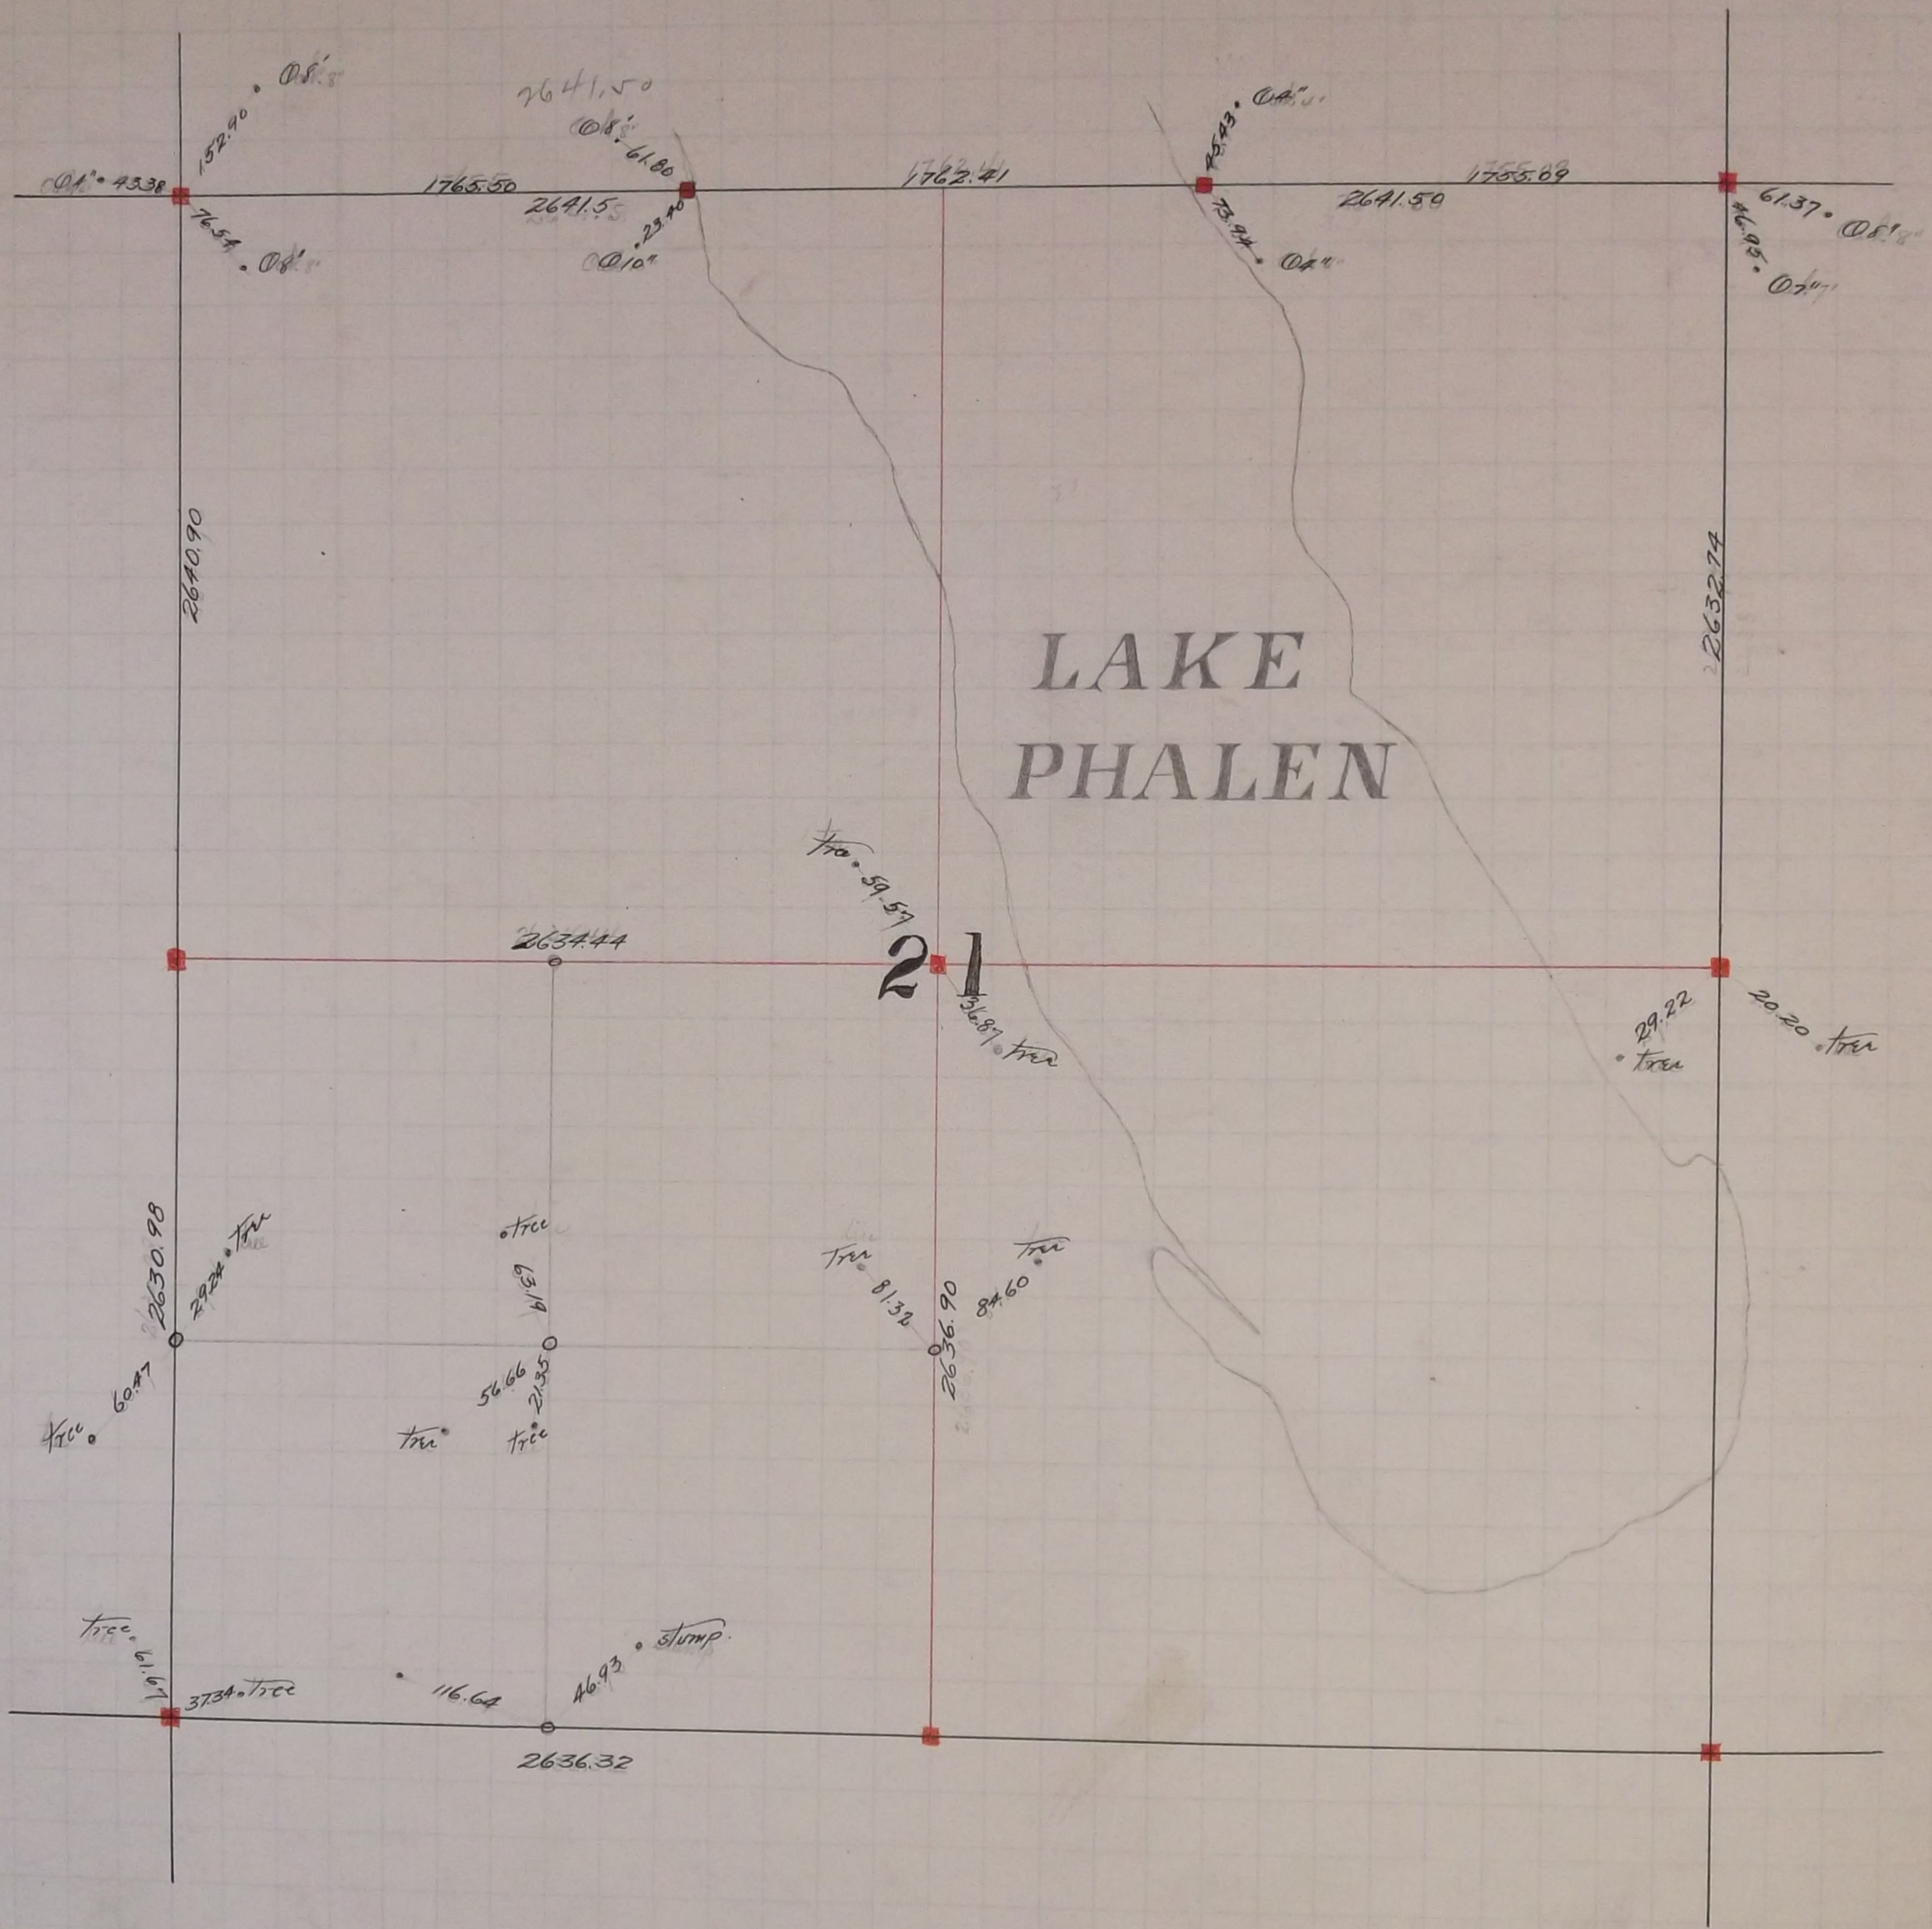
LAKE
PHALEN
21
2641.50
1765.50
1762.41
1755.09
2641.50
2640.90
2632.74
2634.44
2630.98
2636.90
2636.32
152.90
61.80
23.40
45.43
73.94
61.37
46.95
76.54
59.57
36.87
29.22
20.20
29.24
63.19
56.66
21.35
60.47
81.32
84.60
61.67
37.34
116.64
46.93
stump
tree