


od. = 74.98
pope
pople • 59.20

262813

35

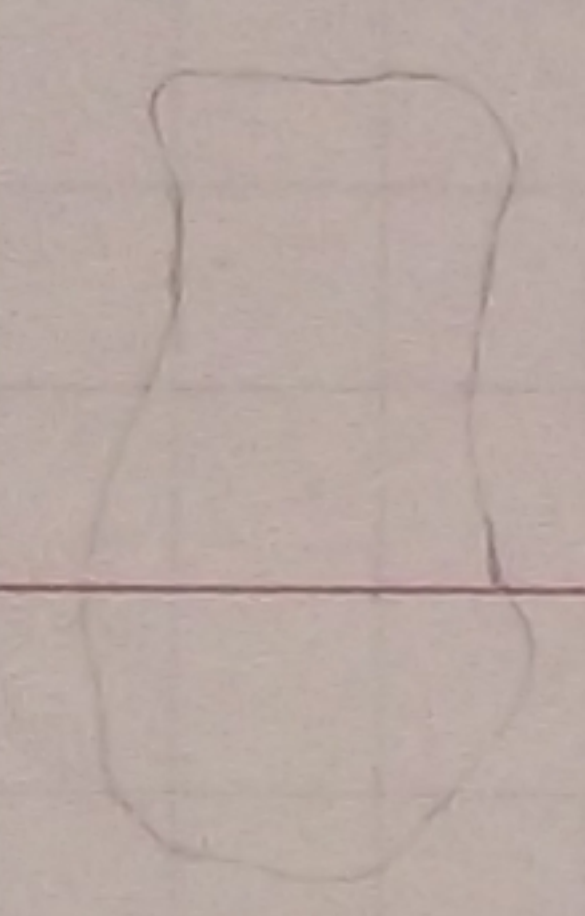

18.45 = free
27.82 = double
rate

262813

double = 81.10
0

56.02 = free

