
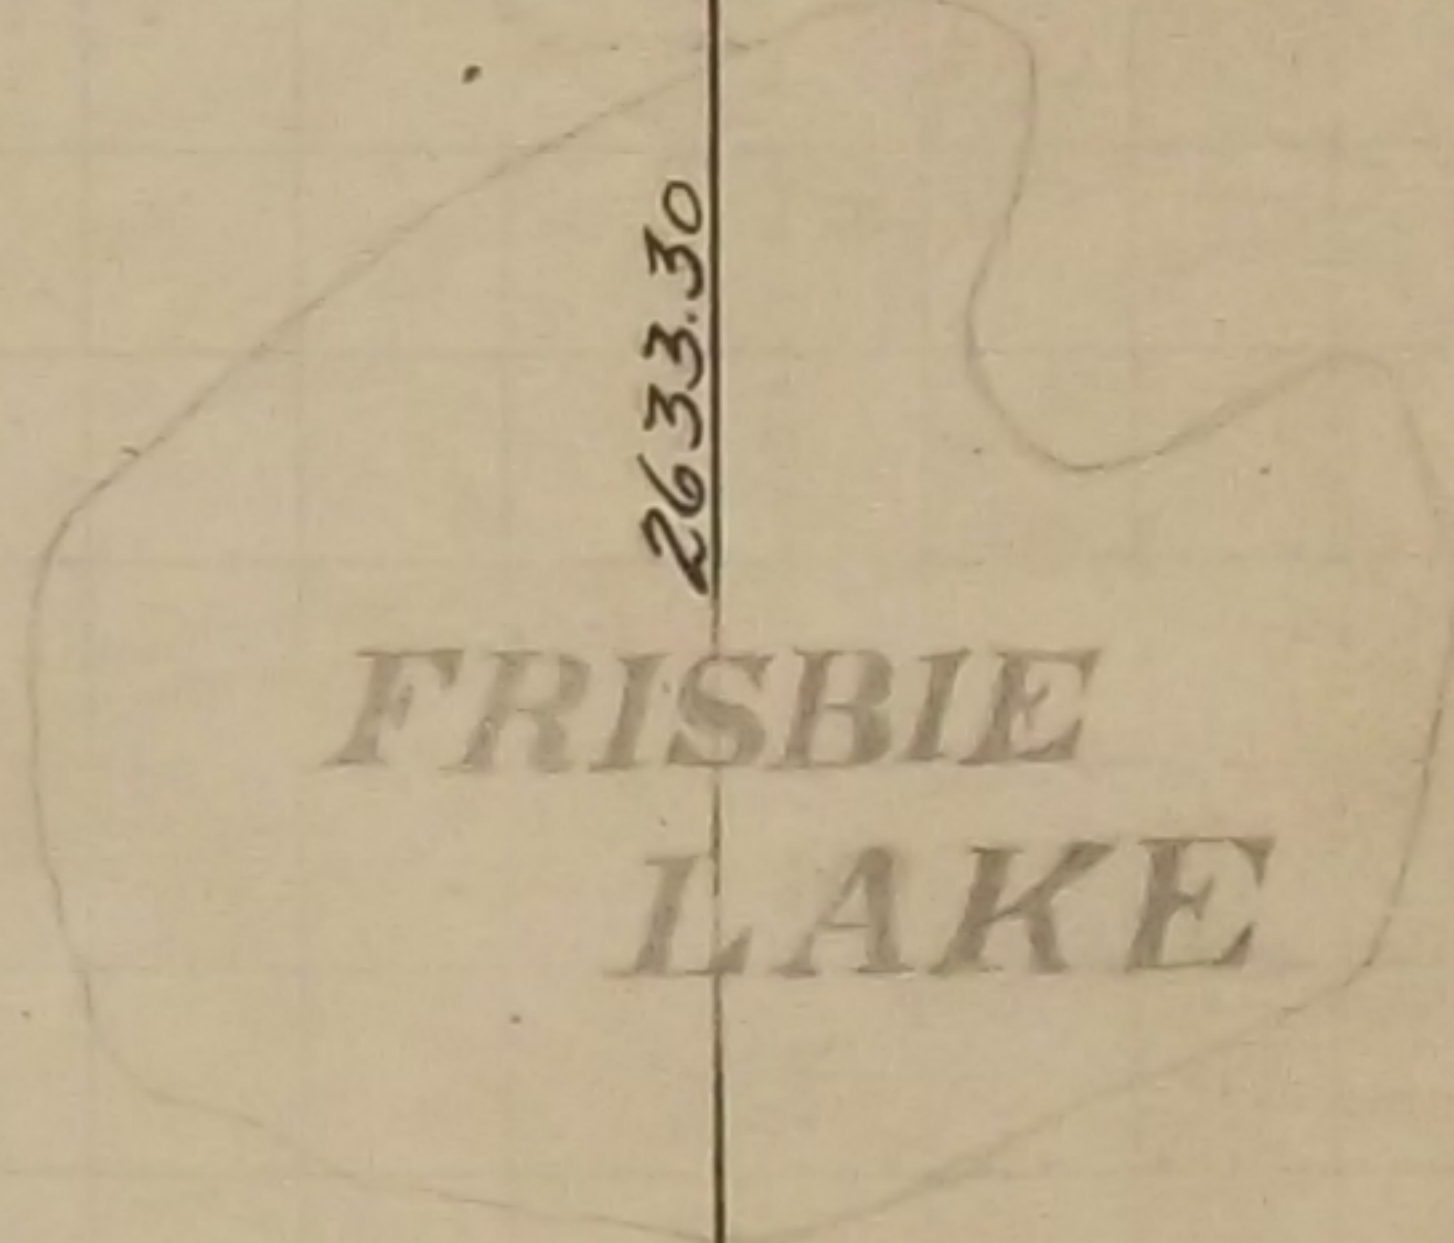
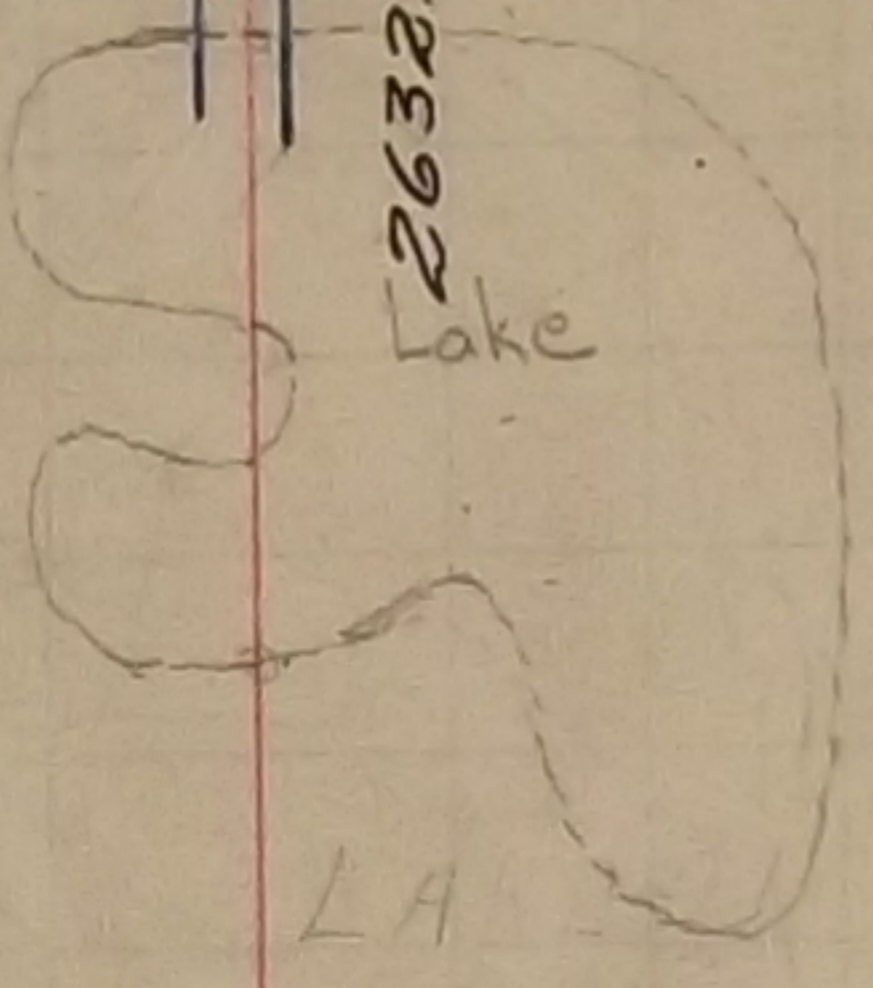


19

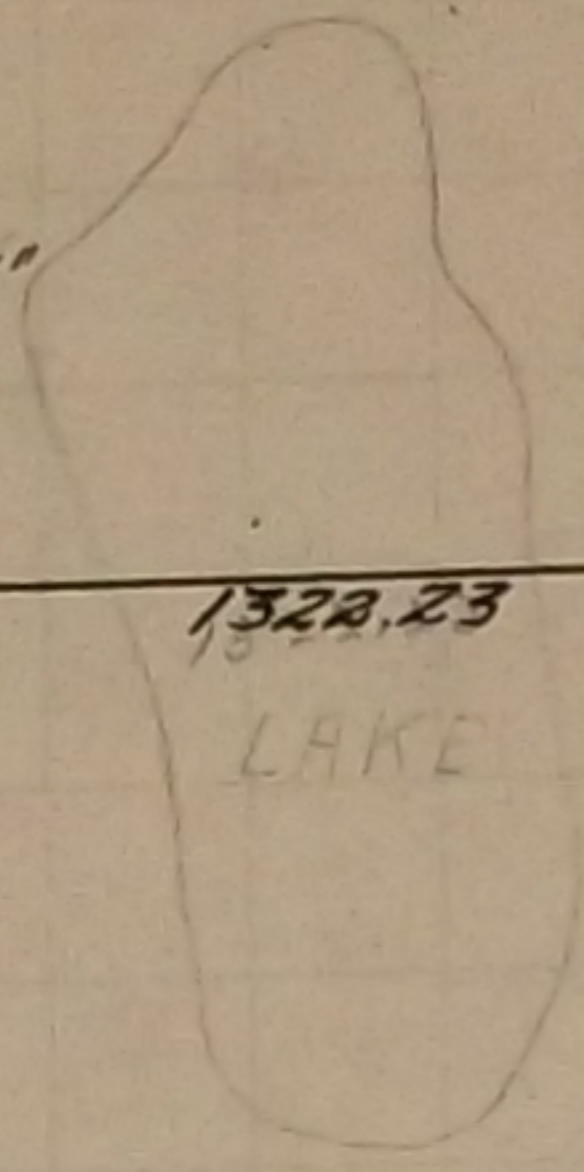

B018'
64.62
51.12
B012'

2219.36
B06"
42.01
39.83
B06'

B06'
62.60

2620.50
2630.50
50.56
64.47
B06"
B04'

EP
25.24
B08'
74.22
88.38
68.70
49.91
B09'
N 1/2 A

897.13

1322.23

35.16
B04"
42.6
B05'

1315.25

1315.25

1314.75

2629.50

46.20
B06"
45.91
B05'

1314.75

1732
B06'

2232.02

1321.12

39.94
F.P.
34.54
F.P.

2643.29

T.P. 42.51
F.P. 33.12
107.79
T.P.
180° 25'

B06"
11.39

910.90

B04"
26.03

1314.75

2629.50

58.68
B08'

1314.75

B010'

32.90
B08'

924.66

1320

B06'
21.67

41.69
temporary
Oak 3"

2640.0

Temporary

B012'
33.31

2244.66

B06'
11.56
58.80
Oak 5'

180°

40.12
F.P. 49.80

7314
61.90
F.P.
32.09
F.P.

2636.28

2636.99M

2633.30

F.P. 33.12

B010'

180° 25'

In Establishing the $\frac{1}{4}$ Corner between Sections 19 and 30 found old stake at $\frac{1}{4}$ Corner and old stump hole of Gov. tree
Sept 17-1898
Set Mont Dec. 1899

The N.E. Corner of Section 19 was fixed from stakes found in Lakeview add to Minneapolis Stock Yards
Gov. witness trees gone
Set Mont. Nov. 1899

In Establishing the $\frac{1}{4}$ Corner between Sections 19 and 20 found old stake at $\frac{1}{4}$ Corner
Gov. witness trees gone
Set Mont. Nov. 1899

In Establishing the N.E. Corner of Section 19 This Corner was fixed from stakes found in Lakeview add. to Minneapolis Stock Yards
no Gov. witness trees
Set Mont. Nov. 1899

In Establishing the N.W. Corner of Section 19 Found old stake near Corner of fence
no Gov. witness trees
June 7-1901
Set Mont. June 30-1901

In Establishing the $\frac{1}{4}$ Corner between Sections 18 and 19 Found stake at $\frac{1}{4}$ Corner and also found stakes in West End add to Minneapolis Stock Yards produced the line N to $\frac{1}{4}$ Corner and Established $\frac{1}{4}$ Corner found one Gov. witness tree stump
June 4-1901
Set Mont. June 23-1901

In Establishing the S.W. Corner of Section 19 Found two Gov. witness tree stumps
fixed Corner and tied it June 26-1901
Set Mont. Aug 10-1901

In Establishing the $\frac{1}{4}$ Corner on the W of Section 19 Run straight line from Section Corner to Section Corner and Established $\frac{1}{4}$ Corner
no Gov. witness trees
June 27-1901
Set Mont. June 30-1901

Fixed Center Section 19 by Intersection Jan 26-1903 and set Mont.