



Willow. 58.25

59.05 Willow

2639.0

tree. 15.52

16.70 tree

1331.0

tree. 7.92


32.44 tree

2662.0

VALENTINE'S LAKE

2640

2633.76

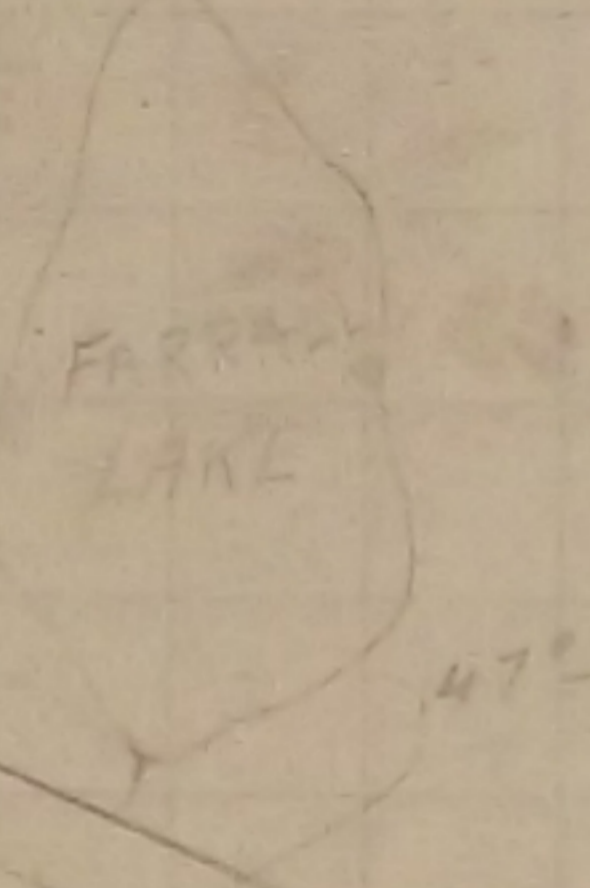

382

2347.04"

28

6452 tree
44.34 tree
58.10 tree

13186
7370.06"

9052
70.20
0.8"

1318.6

1303"

330 tree

45.53 tree

2626.0

MINNEAPOLIS ST. PAUL & 500 STE MARIE

2638.10

925

tree. 71.88

36.78 tree

1316.0

570
0.19"

67.65 FP

1316.0

stake

Gov. tree

tree. 22.35

tree. 33.43

In Establishing the North West Corner of Section 28. Found old stake at Section
Corner Gov. witness tree gone Fixed Cor and set Mark. Dec. 1895-1895

In Establishing the $\frac{1}{4}$ Cor. between Section 21 and 28 Found Iron stake at
 $\frac{1}{4}$ Cor. and our Gov. witness stump Fixed Cor. tied it and
set Mark. Dec. 1895

The North East Cor. of Sec. 28 is in Voluntaries Lake. This Cor. was
was fixed in Dec. 1895-1895.

In Establishing the $\frac{1}{4}$ Cor. between Sections 27 and 28 Found both
Gov. witness stumps and also found old stake at $\frac{1}{4}$ Cor.
Fixed Cor. tied it and set Mark. Dec. 10-1895-1895

In Establishing the South West Cor. of Section 28 Verd Cor. set by Marsh
Found our Gov. witness stump Fixed Cor. and tied it June 4-1897
Set Mark. Aug 4-1897

In Establishing the $\frac{1}{4}$ Cor. between Sections 28 and 33 Found old Gov.
witness tree and old stake June 11-1897 Set Mark. Dec. 8-1899

In Establishing the South East Cor. of Section 28. Found our old Gov.
witness stump and old stake fixed Cor. and tied it June 5-1897 Set Mark. Aug 4-97

In Establishing the $\frac{1}{4}$ Cor. between Sections 28 and 29 found two Old Gov. stumps
fixed Cor. and tied it Dec. 22-1899

Fixed the Center of Sec 28 by Intersection and set Mark. Dec. 1900