

Ramsey County Public Works

Land Survey Division


This survey data is subject to revision and adjustment without notice to you. THE COUNTY DOES NOT WARRANT OR GUARANTEE THE ACCURACY OF THIS DATA. The County disclaims any liability for any injuries, time delays, or expenses you may suffer if you rely in any manner on the accuracy of this data.

- N
- cast iron
- ✕ computed position
- ▲ miscellaneous
- stone
- not identified

Section: 22 Township: 30 Range: 22

Horizontal Coordinate System: Ramsey County
Plane NAD83

Map Prepared: 7/25/2012 Computations: through 2011

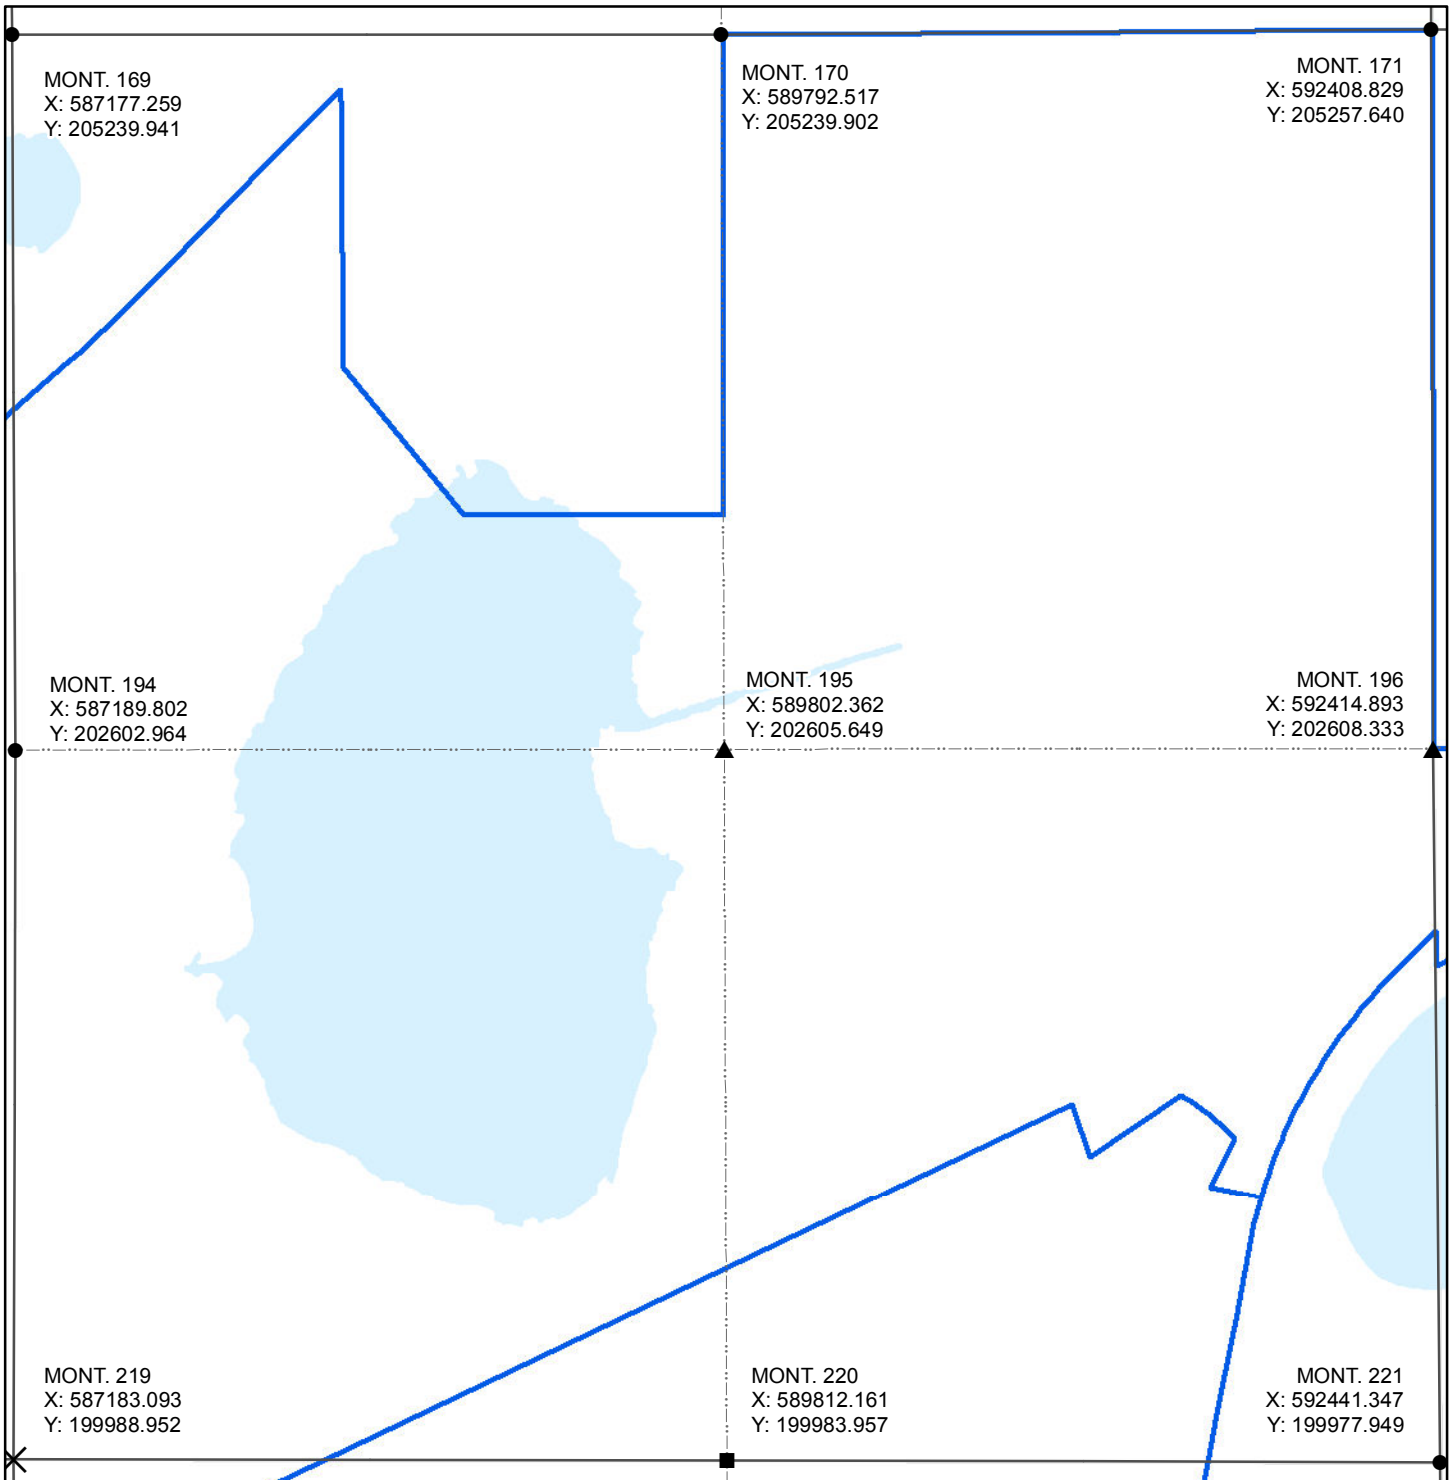

not drawn to scale