




<b>HENNEPIN COUNTY PUBLIC LAND SURVEY TIES</b>		<u>INDEX NO.</u>											
N.E. COR SEC. 7 TWP. 29 RGE. 23		0292307 NE											
<u>COMMENTS:</u> Found C.I.M. even with blacktop in good condition. Existing ties fit well. Retied.		DATE: 1-24-92 TEMP: 10° WEATHER: Sunny MON. TYPE: C.I.M. EQUIPMENT: TOPCON DATE OF LAST CALIBRATION: 11-5-91 <input checked="" type="checkbox"/> EDM STEEL TAPE AT 68°/100.00 = _____ CREW PARTY CHIEF: Lemire Benicke NOTE KEEPER:											
		<table border="1" style="width:100%; border-collapse: collapse;"> <thead> <tr> <th colspan="3">HISTORY</th> </tr> <tr> <th>TWP.</th> <th>RGE.</th> <th>PAGE</th> </tr> </thead> <tbody> <tr> <td style="text-align: center;">29</td> <td style="text-align: center;">23</td> <td style="text-align: center;">7</td> </tr> </tbody> </table>		HISTORY			TWP.	RGE.	PAGE	29	23	7	
HISTORY													
TWP.	RGE.	PAGE											
29	23	7											
		<table border="1" style="width:100%; border-collapse: collapse;"> <thead> <tr> <th colspan="2">MONUMENTS</th> </tr> </thead> <tbody> <tr> <td>C. I. M.</td> <td style="text-align: center;"><input type="checkbox"/></td> </tr> <tr> <td>IRON PIN</td> <td style="text-align: center;"><input checked="" type="checkbox"/></td> </tr> <tr> <td>2" IRON PIPE</td> <td style="text-align: center;"><input type="checkbox"/></td> </tr> <tr> <td>CONCRETE MON.</td> <td style="text-align: center;"><input checked="" type="checkbox"/></td> </tr> </tbody> </table>		MONUMENTS		C. I. M.	<input type="checkbox"/>	IRON PIN	<input checked="" type="checkbox"/>	2" IRON PIPE	<input type="checkbox"/>	CONCRETE MON.	<input checked="" type="checkbox"/>
MONUMENTS													
C. I. M.	<input type="checkbox"/>												
IRON PIN	<input checked="" type="checkbox"/>												
2" IRON PIPE	<input type="checkbox"/>												
CONCRETE MON.	<input checked="" type="checkbox"/>												

**\*NOTE: ALL TIES ARE SIDE TIES WITH NAIL AND DISC UNLESS OTHERWISE SHOWN.**

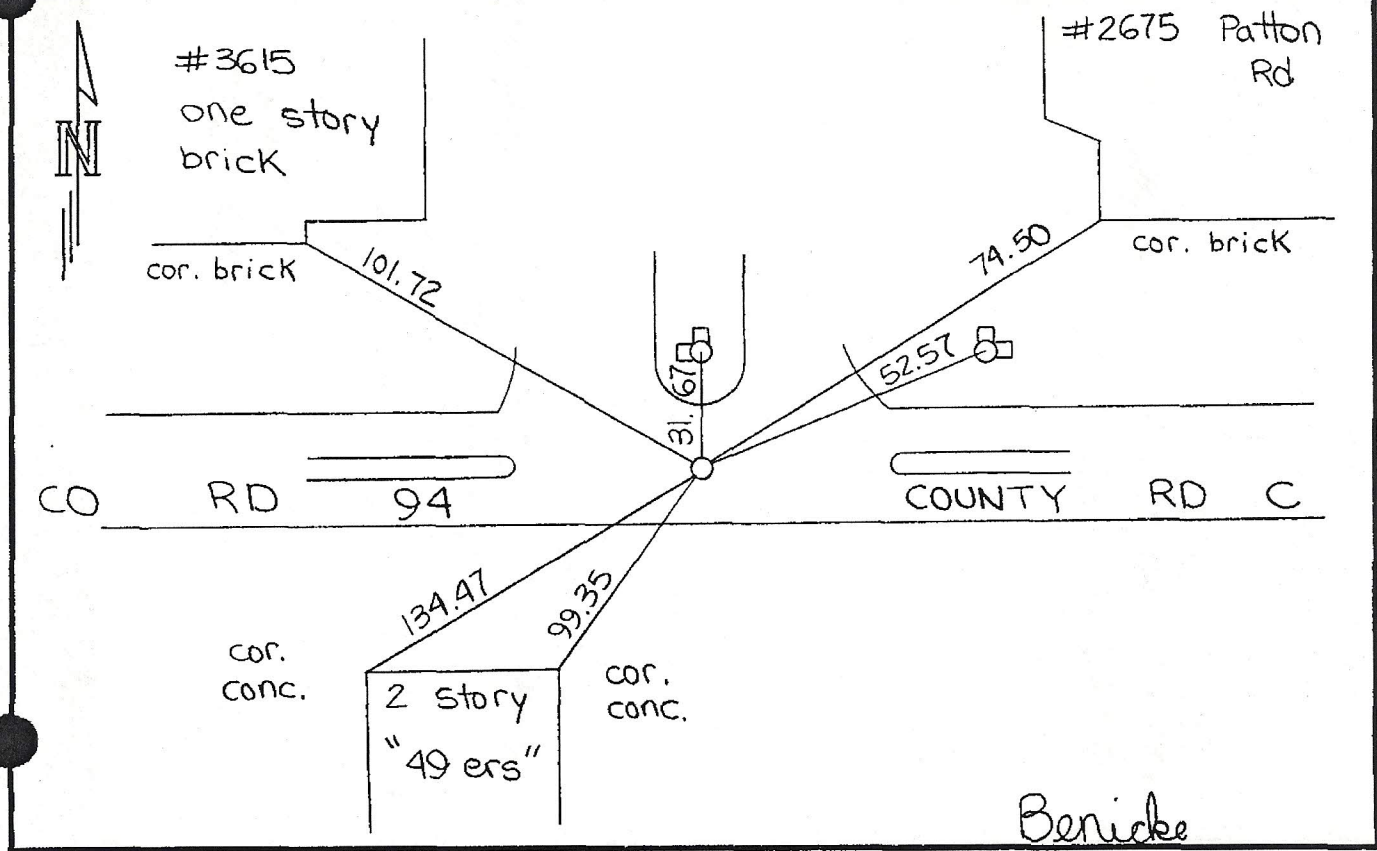

Benicke  
✓ H. Lemire