

7.1

S.E. COR. Sec. 6

T-29 R-23

GRANITE MON. FLUSH IN S OF E-W ROAD

JULY 31 1956 L SEABERG

W SEALBORN

Checked road and

S FELTON

found OK. Additional 100 feet

9-30-64 H.L.

One story

brick

Blg

To check 9-26-64 H.L.

(Area industrial)


O.R. 12-5-75 H.L.

PLATON NO. 384-B

Co. Road

213.05 ±

C

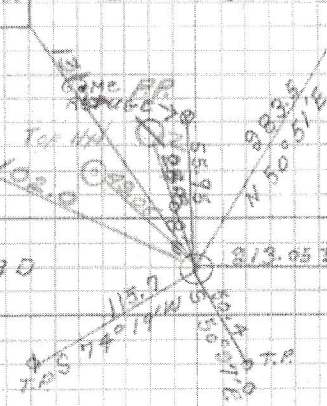

Transferred  
 Acc. 1951, 1955  
 Trans. 10-1-64 B.L.  
 Trans. 9-23-69 JR