

# CERTIFICATE OF LOCATION OF GOVERNMENT CORNER


W 1/4 Corner to Section 17 Township 29N Range 22W No. \_\_\_\_\_

STATE OF MINNESOTA,  
County of Ramsey S.S.

I hereby certify that on the 17 day of October 1962,  
that I, Warren I. Forsberg, a Registered Land Surveyor, ~~County Surveyor,~~  
~~County Highway Engineer,~~ <sup>reset</sup> found the West 1/4 corner of Section 17-T29N R22W

which was evidenced by ties from Maplewood tie book and iron pipe  
in place and I further certify that to perpetuate the  
location of such corner I did, at the exact location thereof, place a permanent marker  
consisting of cast iron monument

I further certify that I established 2 references or witness monuments consist-  
ing of Corner of Foundation & Corner House which reference or witness monuments are  
located in the manner following.

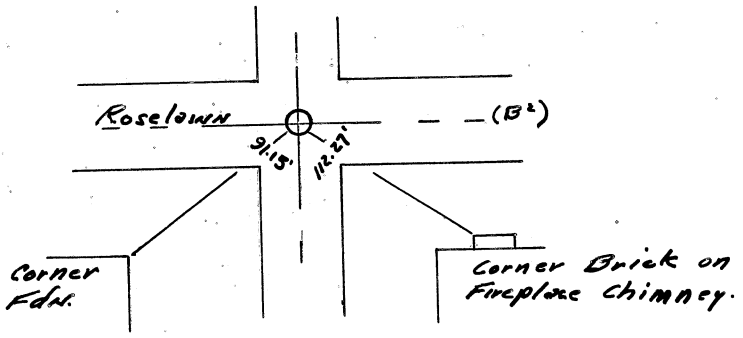

- S.W. Corner Foundation 91.15'
- S.E. Corner Brick on Fire place chimney 112.27'
- Cast iron Monument set flush with surface of road.

Dated at St. Paul, Minnesota, this 17 day of October, 1962.  
Warren I. Forsberg  
~~County Surveyor, County Highway Engineer,~~  
Registered Land Surveyor No. 4840

OFFICE OF THE REGISTER OF DEEDS  
County of \_\_\_\_\_

I hereby certify that the within instrument was filed in this office for record on the  
\_\_\_\_\_ day of \_\_\_\_\_ A.D., 19\_\_\_\_.

Register of Deeds  
By \_\_\_\_\_, Deputy