

CERTIFICATE OF LOCATION OF GOVERNMENT CORNER

W 1/4 Corner to Section 13 Township 29N Range 22W No. _____


STATE OF MINNESOTA,

County of Ramsey S.S.

I hereby certify that on the 17 day of October 1962,
 that I, Warren I. Forsberg, a Registered Land Surveyor, ~~County Surveyor,~~
~~County Highway Engineer,~~ ^{reset} found the West 1/4 corner of Section 13-T29N-R22W
 which was evidenced by Ties from Maplewood tie book

_____ and I further certify that to perpetuate the
 location of such corner I did, at the exact location thereof, place a permanent marker
 consisting of NO MONUMENT SET AT THE CORNER

I further certify that I established 2 references or witness monuments consist-
 ing of cast iron monuments, 33.0 N + W which reference or witness monuments are
 located in the manner following.

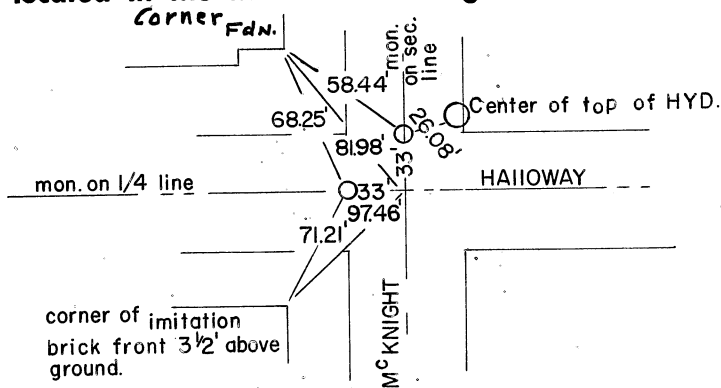

Dated at St. Paul, Minnesota, this 27 day of December, 1962.

Warren I. Forsberg
~~County Surveyor, County Highway Engineer,~~
 Registered Land Surveyor No. 4840

OFFICE OF THE REGISTER OF DEEDS

County of _____

I hereby certify that the within instrument was filed in this office for record on the
 _____ day of _____ A.D., 19____.

Register of Deeds

By _____, Deputy