

CERTIFICATE OF LOCATION OF GOVERNMENT CORNER

MON. NO. 24
old index 1503

W 1/4 Corner of Section 21 Township 29 Range 23, 4TH P.M.


STATE OF MINNESOTA, County of Ramsey

At the corner location shown on the sketch:

On 6-16-97 found a Granite monument 0.20 below grade

- left monument as found lowered monument removed monument (explain)

On _____ placed a _____

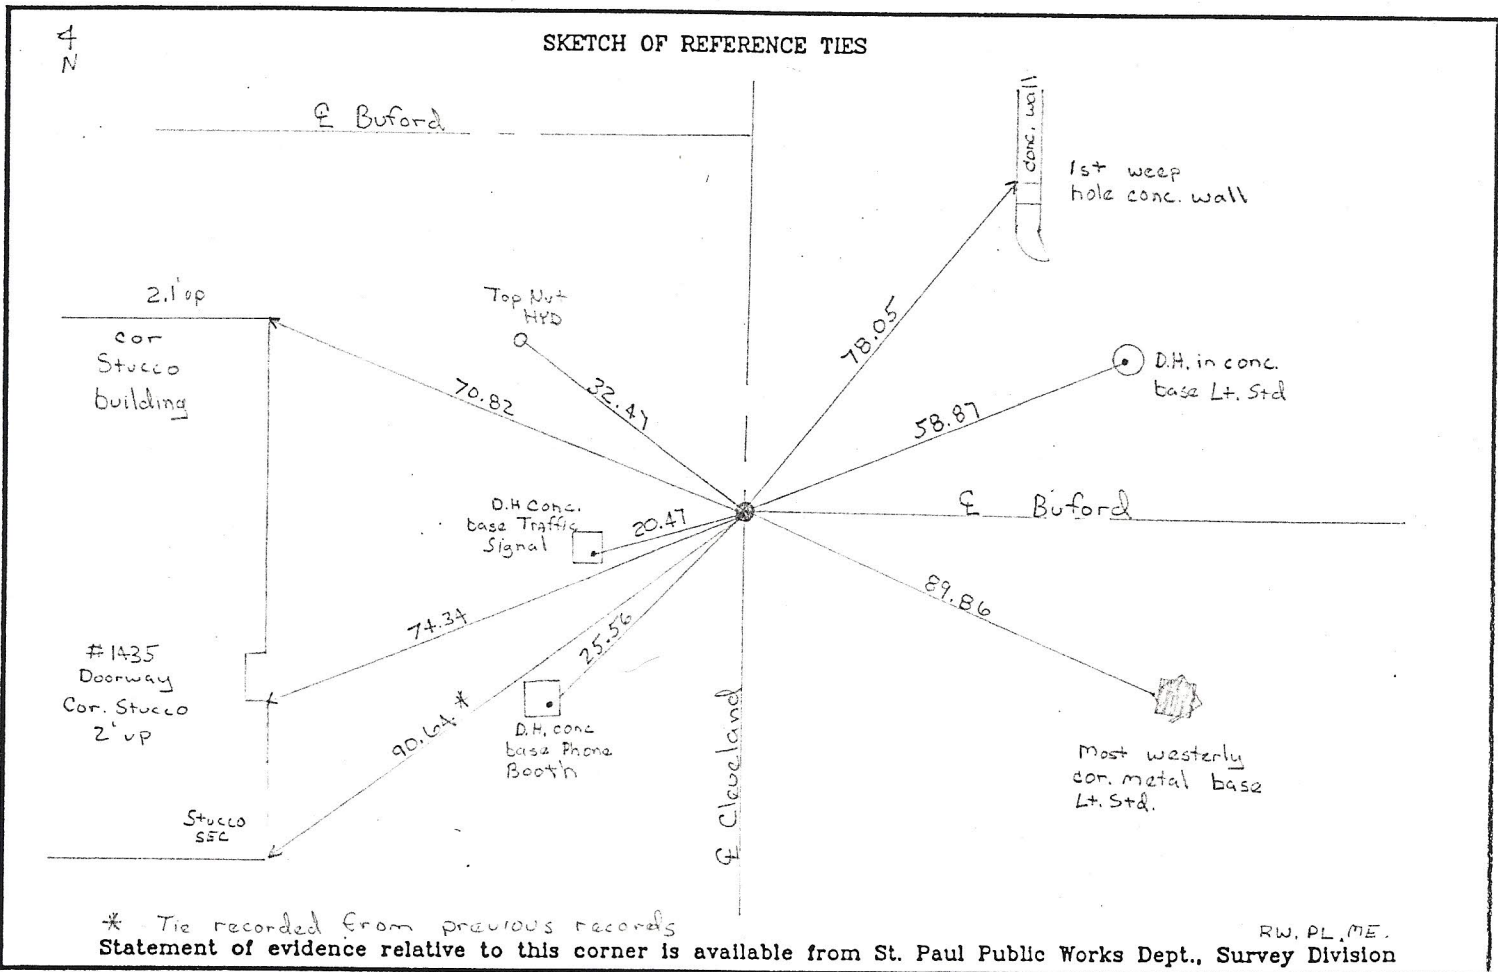

I hereby certify that this document and the data contained herein was prepared by me or under my direct supervision.

Donald O. Claypool Oct 10, 97
SIGNATURE DATE

Registration No. 13298

- Land Surveyor County Surveyor
 Professional Engineer
 Chief Surveyor, City of St. Paul

Office of The County Recorder, County of Ramsey

I hereby certify that this document was filed in the county

Recorders office at _____ m. on the _____ day of _____

County Recorder _____

By _____, Deputy

DOCUMENT NUMBER _____