0053-0017-A

Index No. 53
old Index 17

CERTIFICATE OF LOCATION OF GOVERNMENT CORNER

North West Corner of Section 30, Township 29, Range 22, 4th P.M.

STATE OF MINNESOTA, County of Ramsey

At the corner location shown on the sketch:

☒ On 7/29/1991 found a Granite Monument 0.4' below existing Road ~~Asphalt~~ Surface

☒ left mon. as found ☐ lowered mon. ☐ removed mon.(explain)

☐ On ___ placed a _____

SKETCH OF REFERENCE TIES

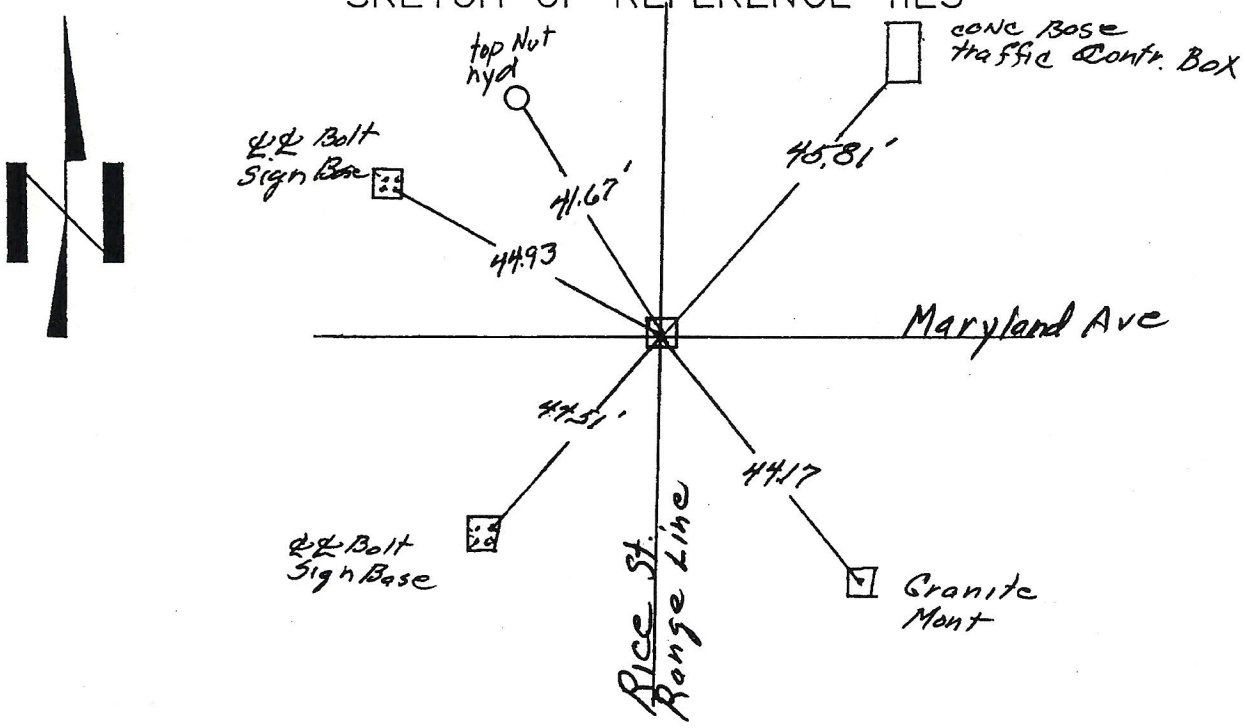

Statement of evidence relative to this corner location is on back of page.

I hereby certify that this document and the date contained herein was prepared by me or under my supervision.

William J Cuttinger 8/05/1991
Signature date

Registration No. 20576

☒ Land Surveyor ☐ Professional Engineer

☐ County Surveyor ☐ County Engineer

Office of the Register of Deeds

County of _____

I hereby certify that this document was filed in the Reg.of Deeds office at ____.M. on the day of ____ A.D.,19__

Register of Deeds _____ By _____

DOCUMENT NO. _____

Scanned 3/11/199 MPM