0058-0027-A

Index No. 58
old Index 27

CERTIFICATE OF LOCATION OF GOVERNMENT CORNER

1/4 Corner of Section 28, Township 29, Range 22, ____ P.M.

STATE OF MINNESOTA, County of Ramsey

At the corner location shown on the sketch:

☐ On 6-23-93 (DATE) found a CIM

☒ left monument as found, ☐ lowered monument, ☐ removed monument (exploin)

☐ On _____ (DATE) placed a _____

SKETCH OF REFERENCE TIES

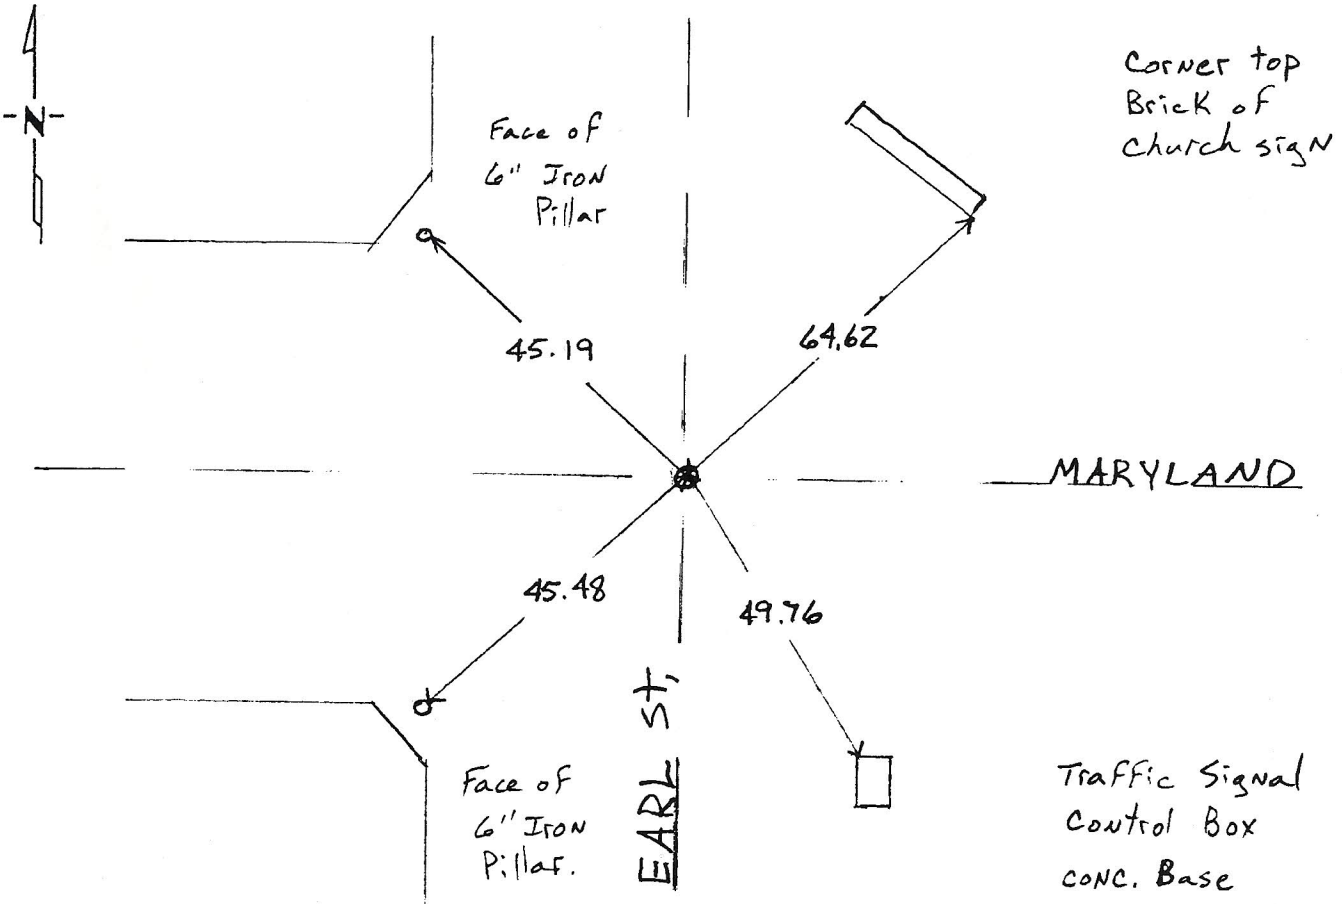

Statement of evidence relative to this corner location is on back of page.

I hereby certify that this document and the data contained herein was prepared by me or under my direct supervision.

REGISTERED LAND SURVEYOR

_____ (SIGNATURE) June 29 1993 (DATE)

Registration No. _____

☒ Land Surveyor, ☐ Professional Engineer

☐ County Surveyor, ☐ County Engineer

OFFICE OF THE COUNTY RECORDER

County of _____

I hereby certify that this document was filed in the Co. Recorders office at _____ .M. on the _____ day of _____ A.D., 19 ___

County Recorder _____

By _____, Deputy

DOCUMENT NO. _____

Scanned 3/11/99 mm