

CERTIFICATE OF LOCATION OF GOVERNMENT CORNER

North West Corner of Section 27, Township 29, Range 22, 4th P.M.

STATE OF MINNESOTA, County of Ramsey


At the corner location shown on the sketch:

On _____ found a _____

left mon. as found lowered mon. removed mon.(explain)


On April 29 placed a Concrete Mont

SKETCH OF REFERENCE TIES

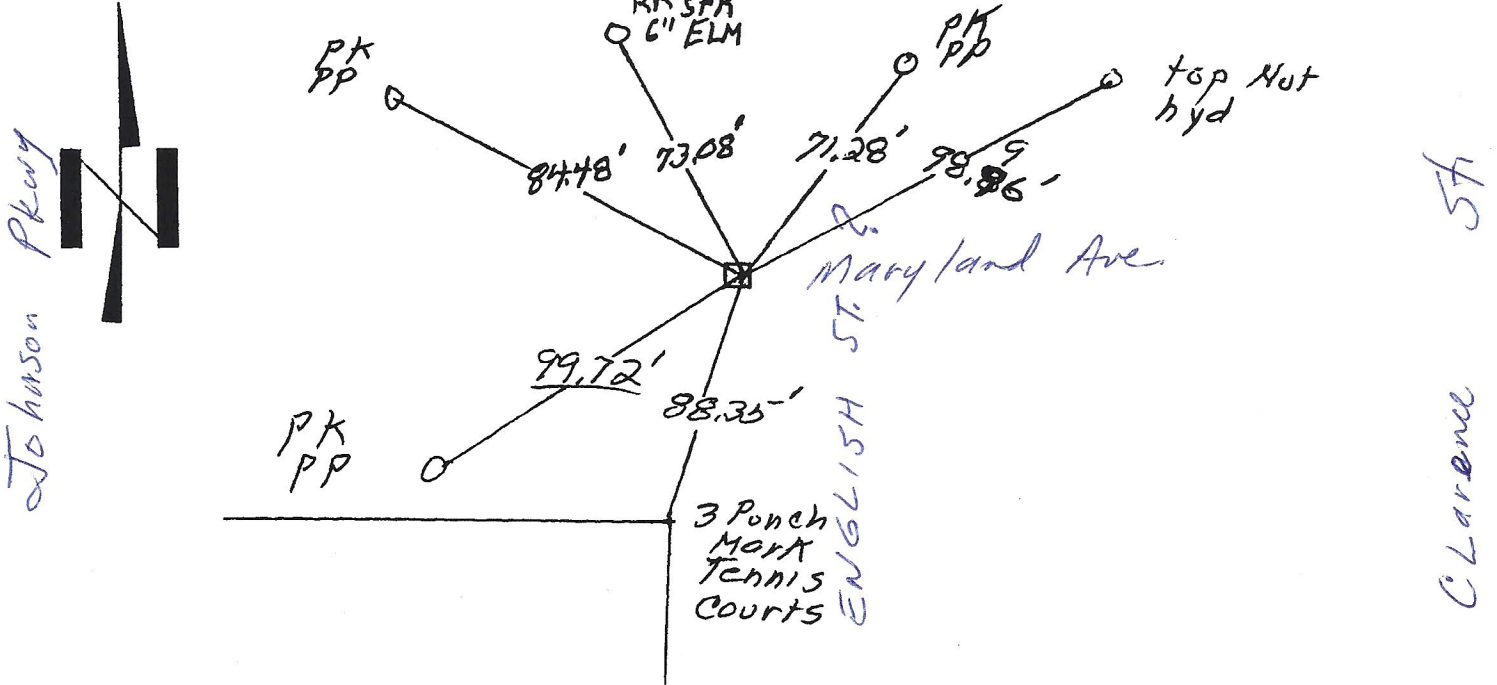

Statement of evidence relative to this corner location is on back of page

I hereby certify that this document and the date contained herein was prepared by _____ or under my supervision.

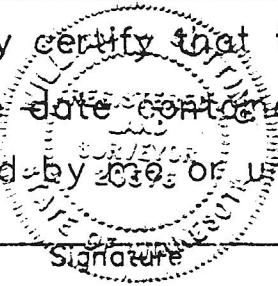

Signature

April 29, 1922
date

Office of the Register of Deeds
County of _____

I hereby certify that this document was filed in the Reg. of Deeds office at _____ M.

on the _____ day of _____ A.D., 19____
Register of Deeds _____ By _____

Registration No. _____

Land Surveyor Professional Engineer

County Surveyor County Engineer

DOCUMENT NO. _____