

CERTIFICATE OF LOCATION OF GOVERNMENT CORNER

MON. NO. 221

old index 175

SE Corner of Section 7 Township 28 Range 22, 4th P.M.


STATE OF MINNESOTA, County of Ramsey

At the corner location shown on the sketch:

On 5-14-97 found a CIM @ grade - removed for
date
street construction

- left monument as found lowered monument removed monument (explain)

On 9-11-97 placed a CIM in asphalt @ finish grade
date

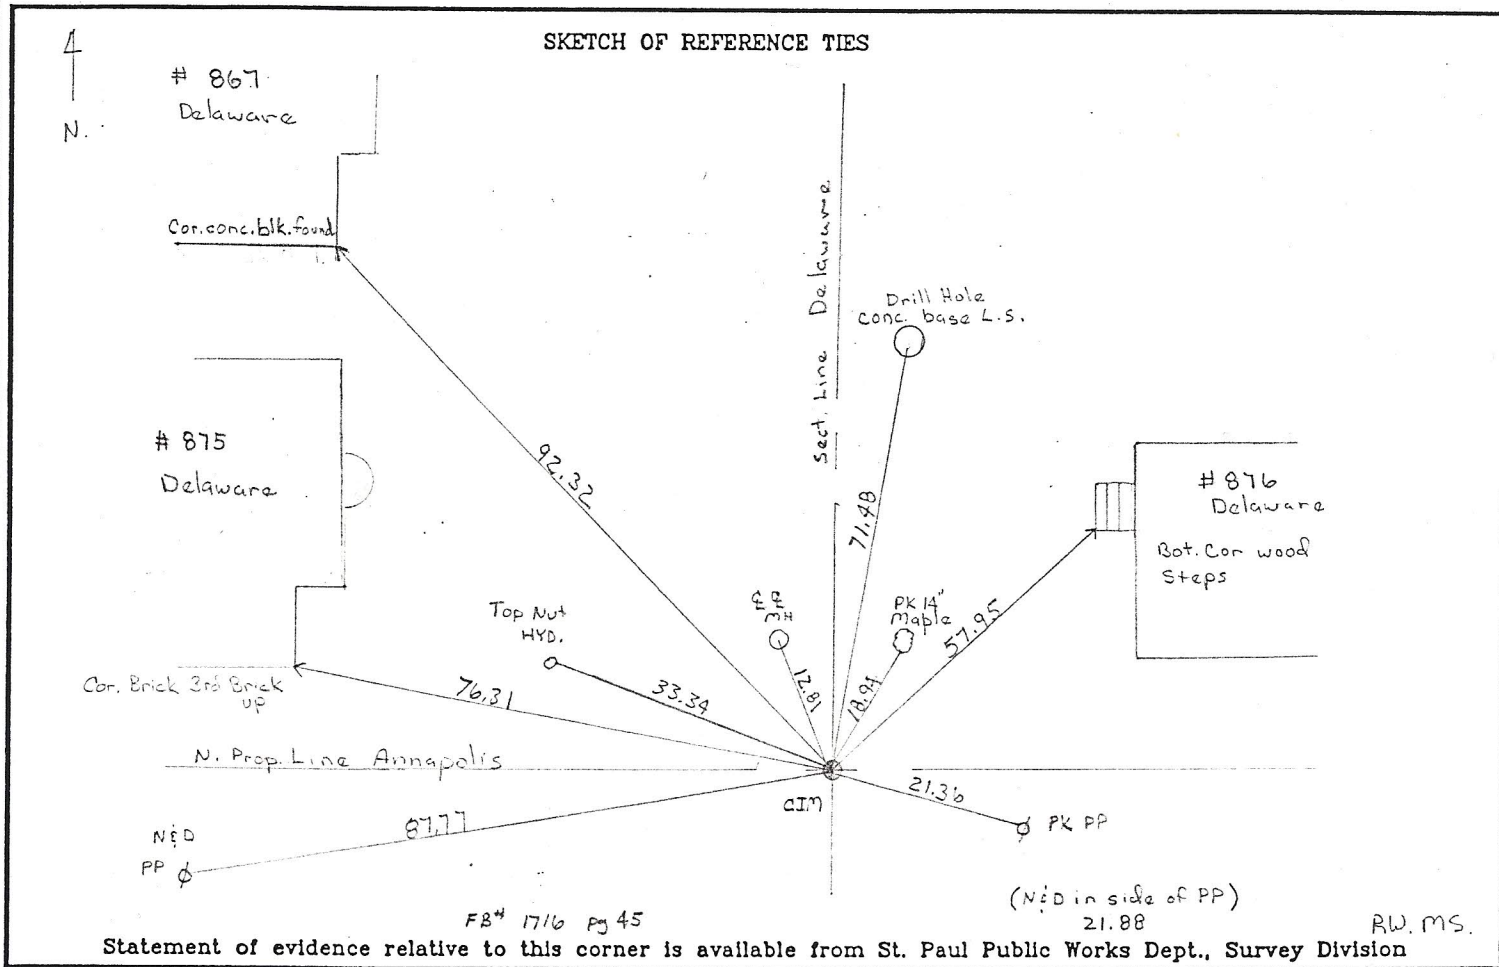

I hereby certify that this document and the data contained herein was prepared by me or under my direct supervision.

[Signature] Oct 10, 97
SIGNATURE DATE

Registration No. 13298
 Land Surveyor County Surveyor
 Professional Engineer
 Chief Surveyor, City of St. Paul

Office of The County Recorder, County of Ramsey

I hereby certify that this document was filed in the county

Recorders office at _____ m. on the _____ day of _____

County Recorder _____

By _____, Deputy

DOCUMENT NUMBER _____