


36" EUM SET SPREAD
EAGLE
OF 60p SPK
IN BLZ

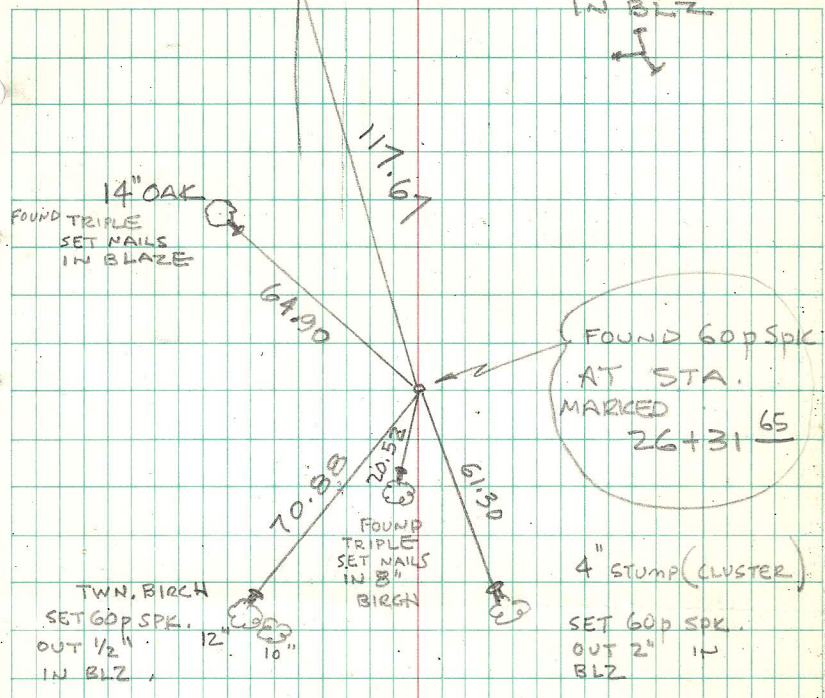

DIETZEN NO. 384-3

2/18/65

N 1/4 CORNER
SEC. 17-30-23

