


N 1/4 Corner Sec 1 - 30-23

July 27, 1972

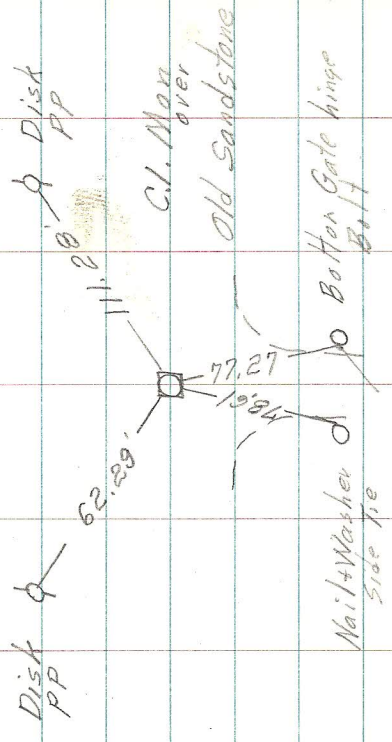

X