


N. E. Corner Section 1-30-23

July 27, 1972

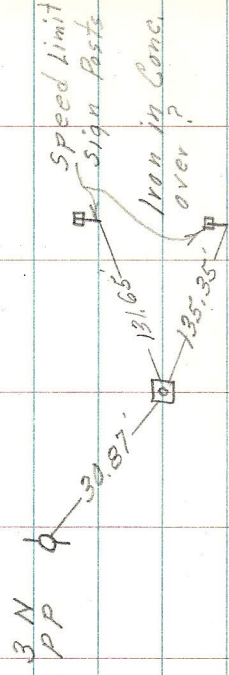

X