


N.W. Corner Sec 19 T 30 R 23

S.W. Corner Sec 18

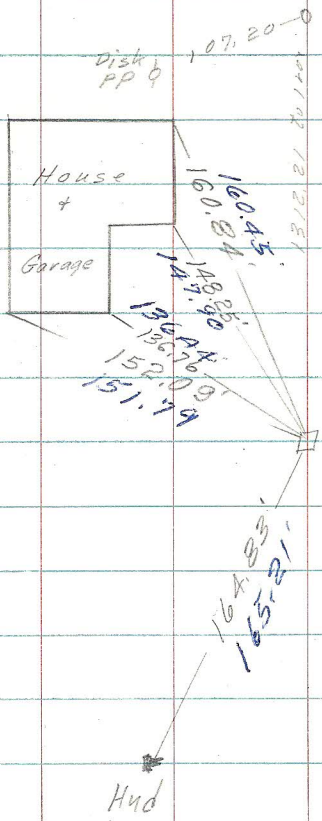

Pencil when
Tipped

streightened &
re-tied

X