

SW Corner Section 13-30-23


14

13

S.T.H.

No. 96

C.I. Mon.

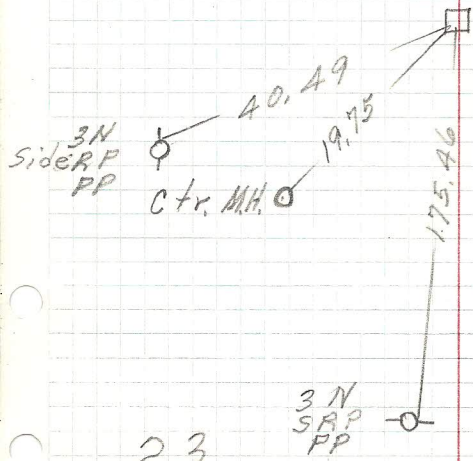

OVR Ties

23

24

Snail Lake

X