


RG  
FS  
WS  
DS  
LPP

Apr. 5, 1905  
35° cloudy

Ctr. Sec 23-30-23W

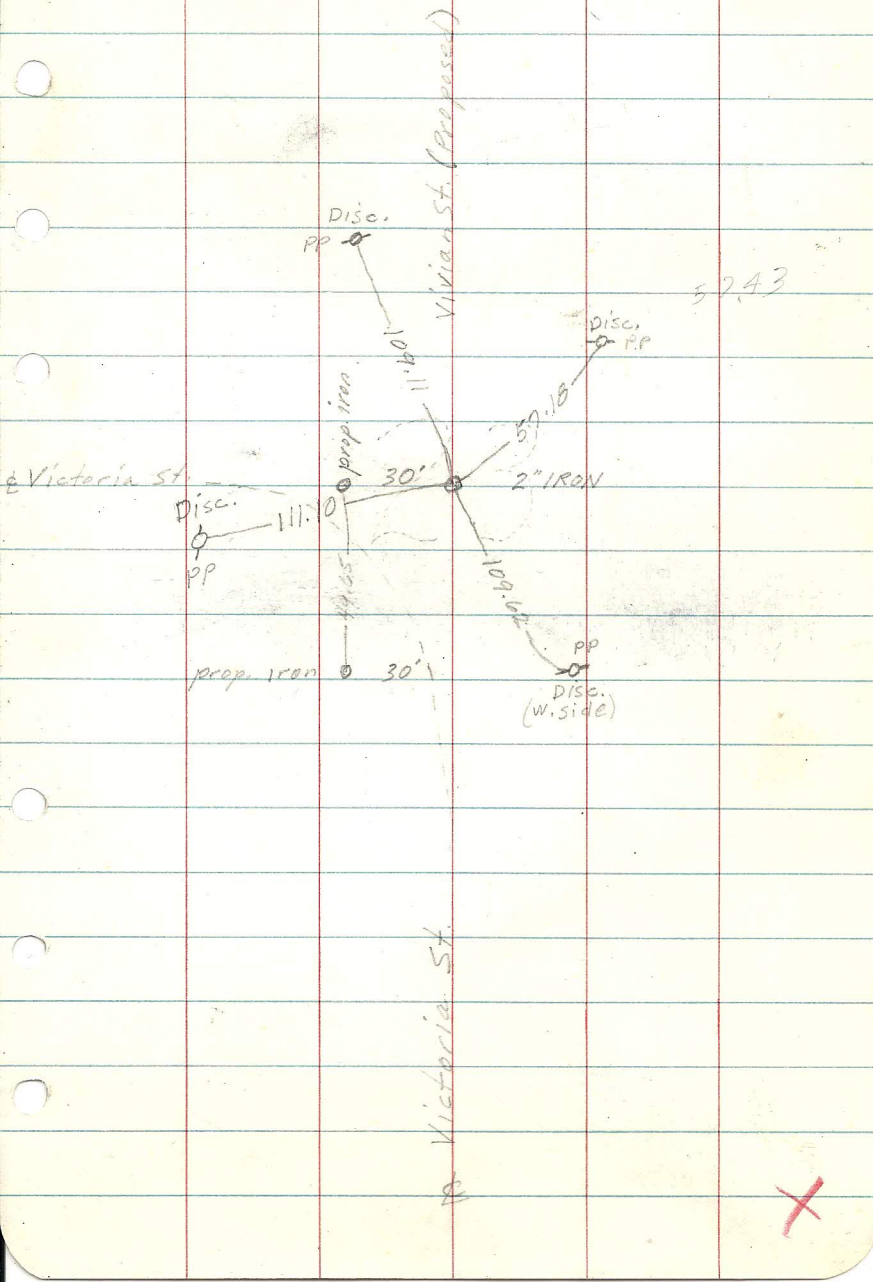

X