


20 21  
29 28

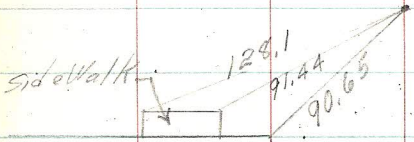

3/4" Iron pin  
Flush With Bit Surface  
Punch mark  
10-28-64

St. Johns  
School

