


Center Section 30-30-23

FK
DS Sept 16, 1971
CB
PH

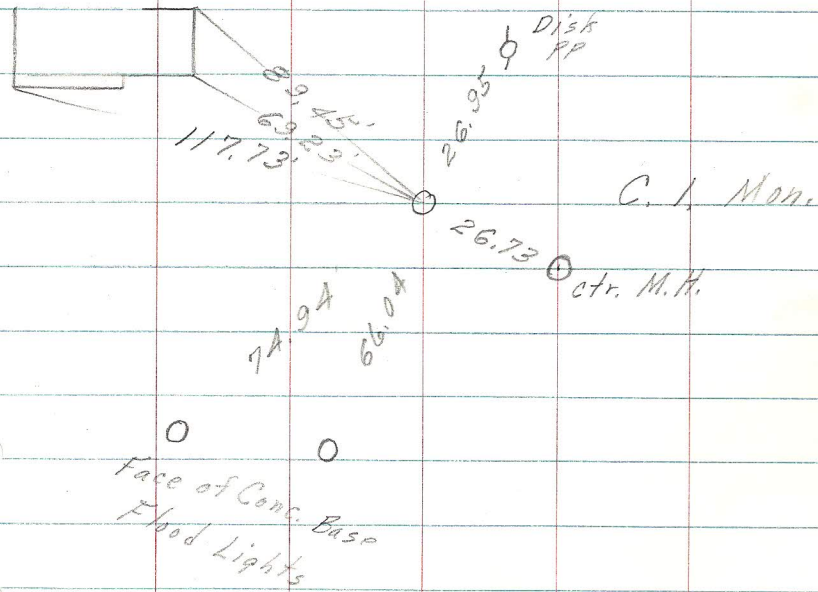

X