


Center Section 29-30-23

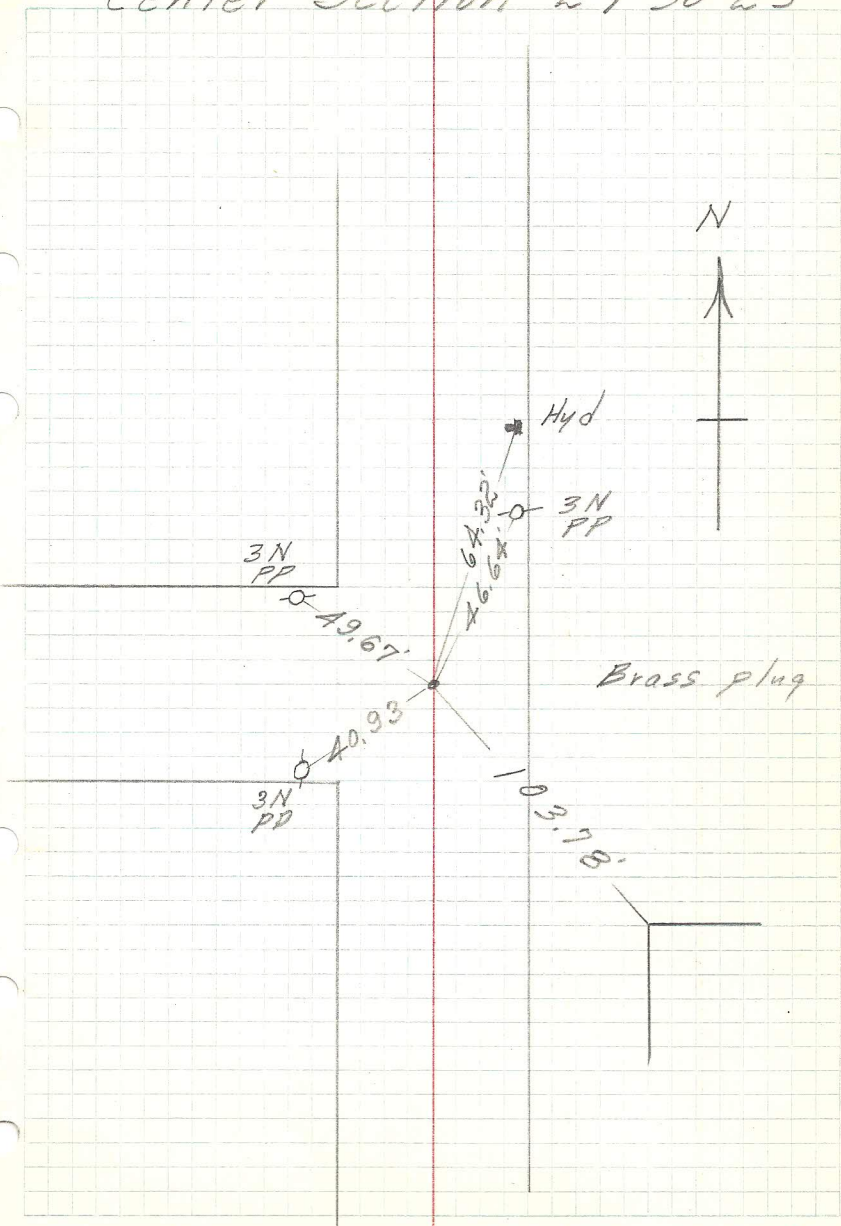

X