


RG
VMM
RB
WS

March 6, 1962
10° cloudy

Sec 27 T30 R23W

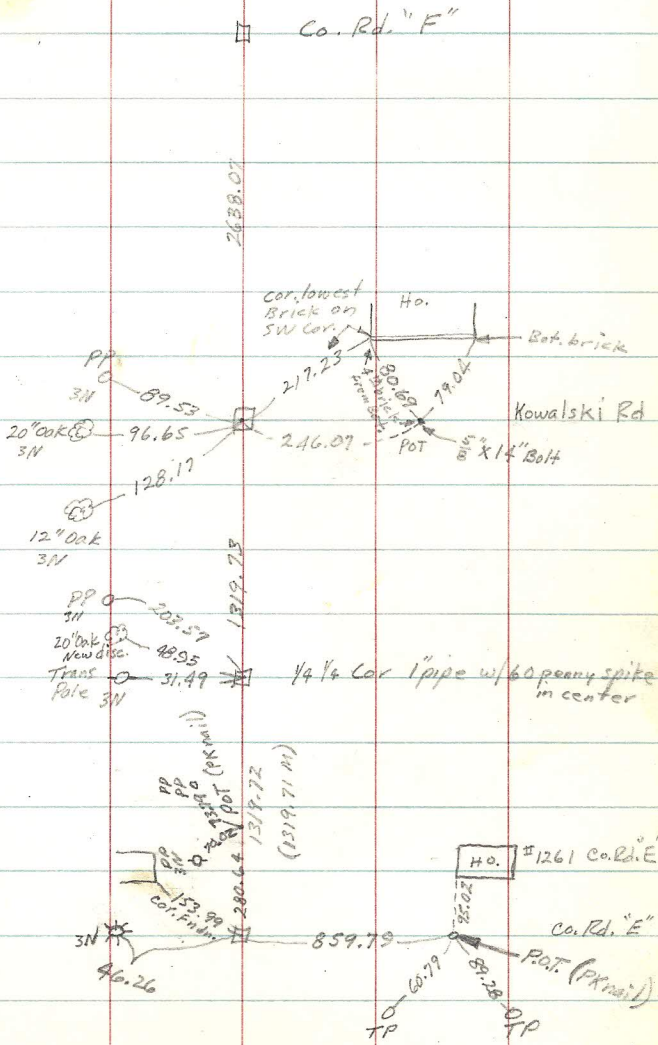

X