


Center Section 25-30-23

GRASS Lake

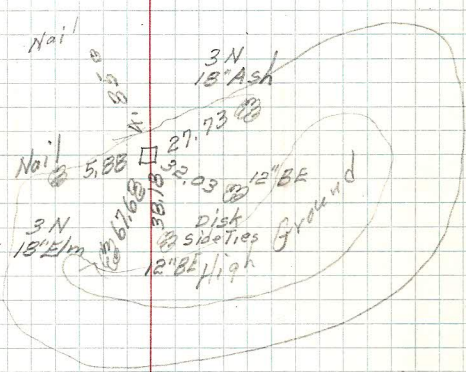

GRASS LAKE

X