


# Section Corner

Common to

Sections 29, 30, 31 & 32

T 30 N - R 23 W

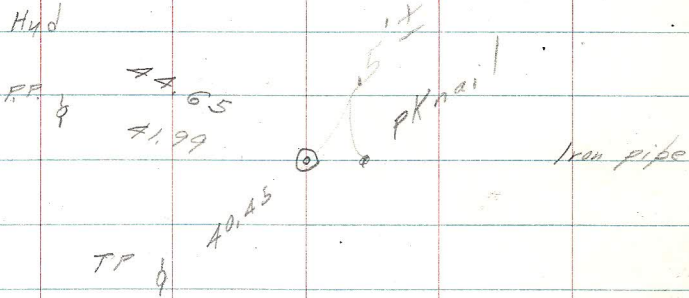

X