


W 1/4 Corner Sec. 6-30-23

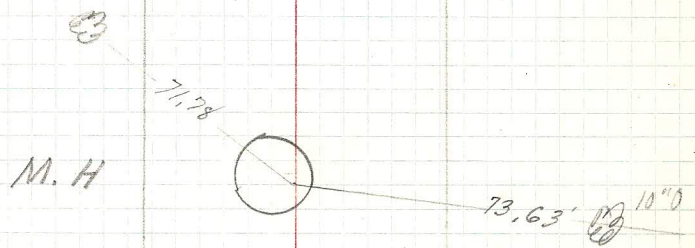

X