


W 1/4 Corner Sec. 5 - 30-23

E 1/4 Corner Sec 6 - 30-23

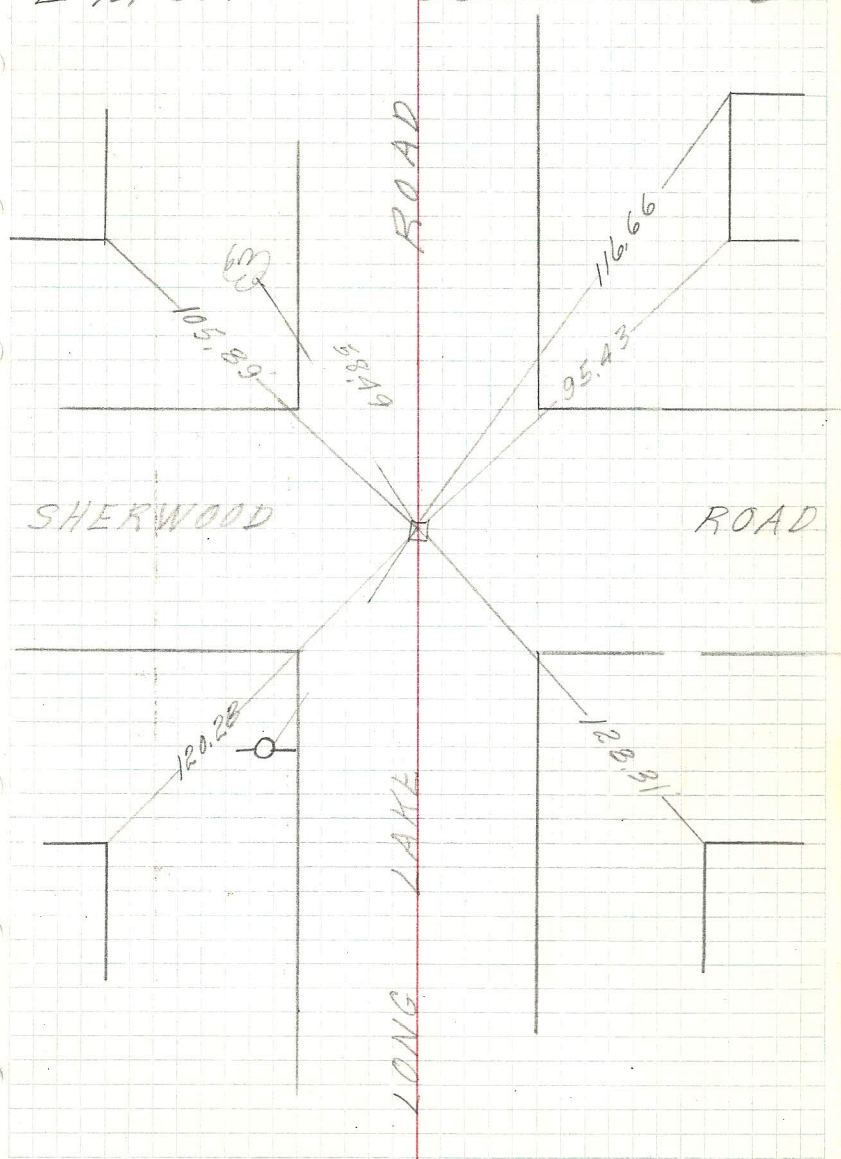

X