


NE COR S 7-T30-R23

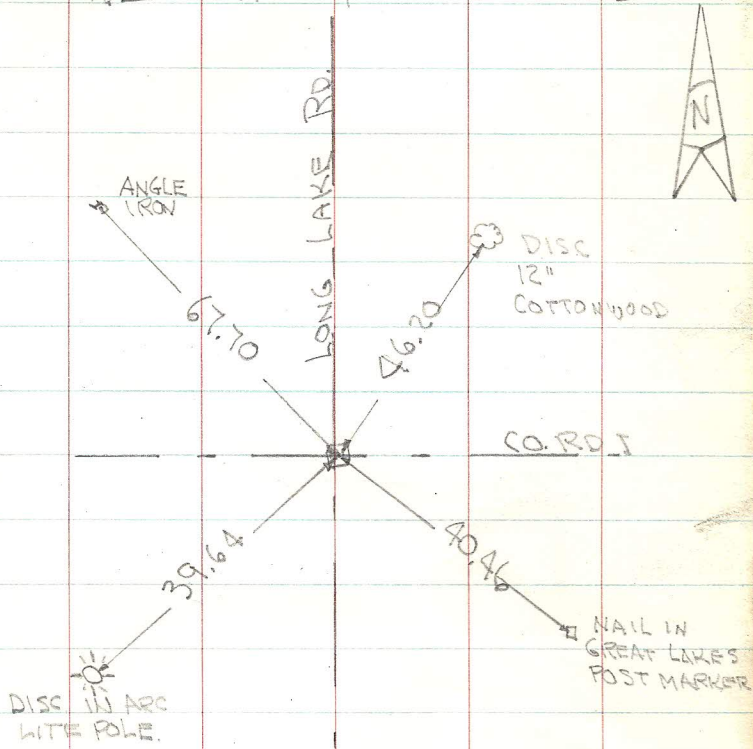

X