


S 1/4 Cor. Sec. 4 - 30 - 23

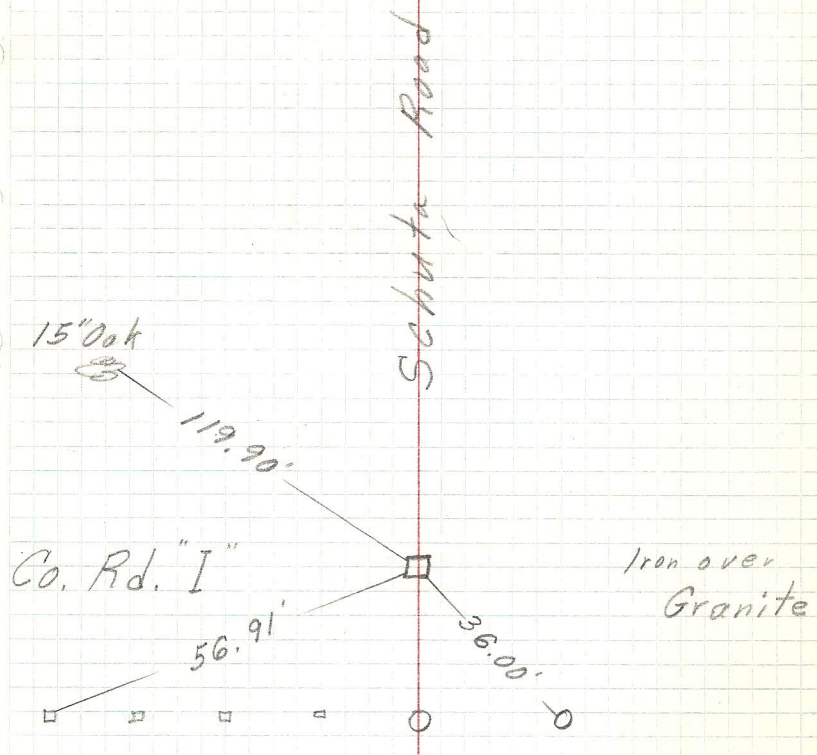

X