


S ¹/₄ Corner Section 2 } 730-R23
 N ¹/₄ Corner Section 1 } 1971 Rd

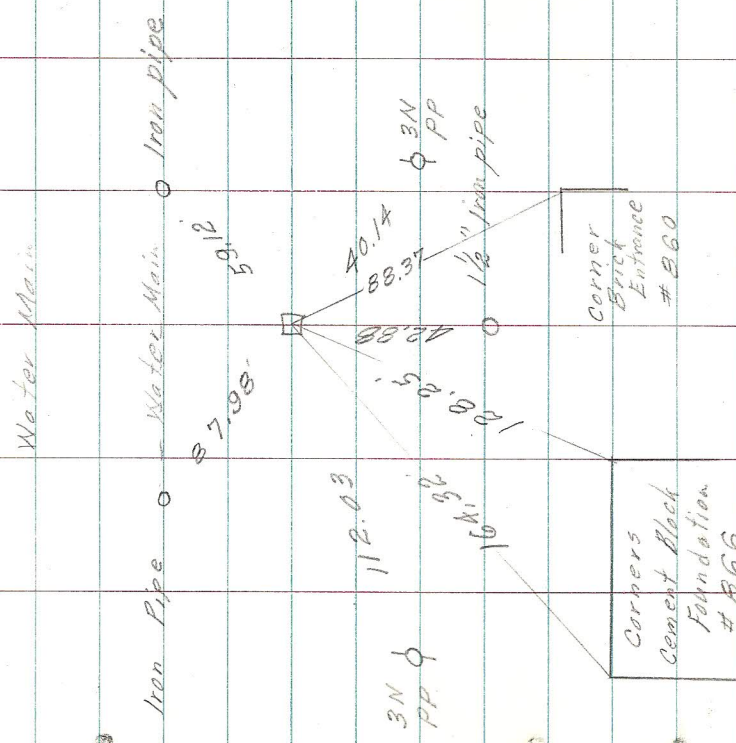

X