

Have You Checked Your Sanitary Supplies Today?

ROCHESTER GERMICIDE CO.


592 N. Snelling Ave.

ST. PAUL 4, — MINNESOTA

PHONE ROBERT C. CAMPBELL

Nestor 7449

SEC 7

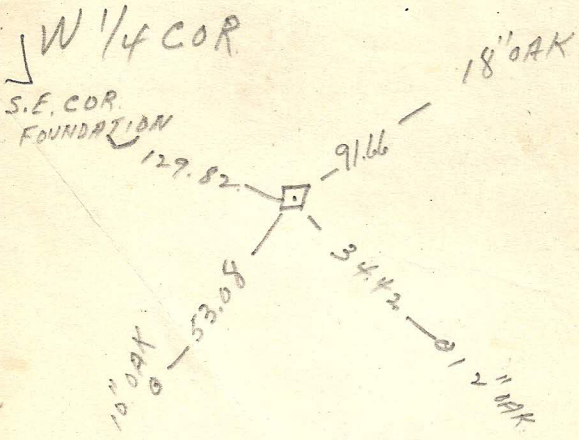

X