


M.C. W. Line of SE 1/4  
Section 20-30-23

LONG LAKE

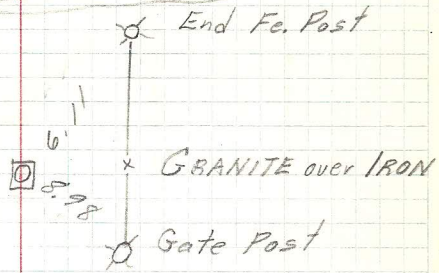

+