

# CERTIFICATE OF LOCATION OF GOVERNMENT CORNER


DEFENDER Corner of Section 9, Township 30, Range 22, 4<sup>TH</sup> P.M.

STATE OF MINNESOTA, County of RAMSEY

At the corner location shown on the sketch:

- On 1946 found a GRANITE MONUMENT ON EAST LINE SEC 9  
DATE 550.0 SOUTH OF EAST 1/4 CORNER. (COUNTY DISTANCE)
- left monument as found,  lowered monument,  removed monument (explain)
- On \_\_\_\_\_ placed a \_\_\_\_\_  
DATE

### SKETCH OF REFERENCE TIES

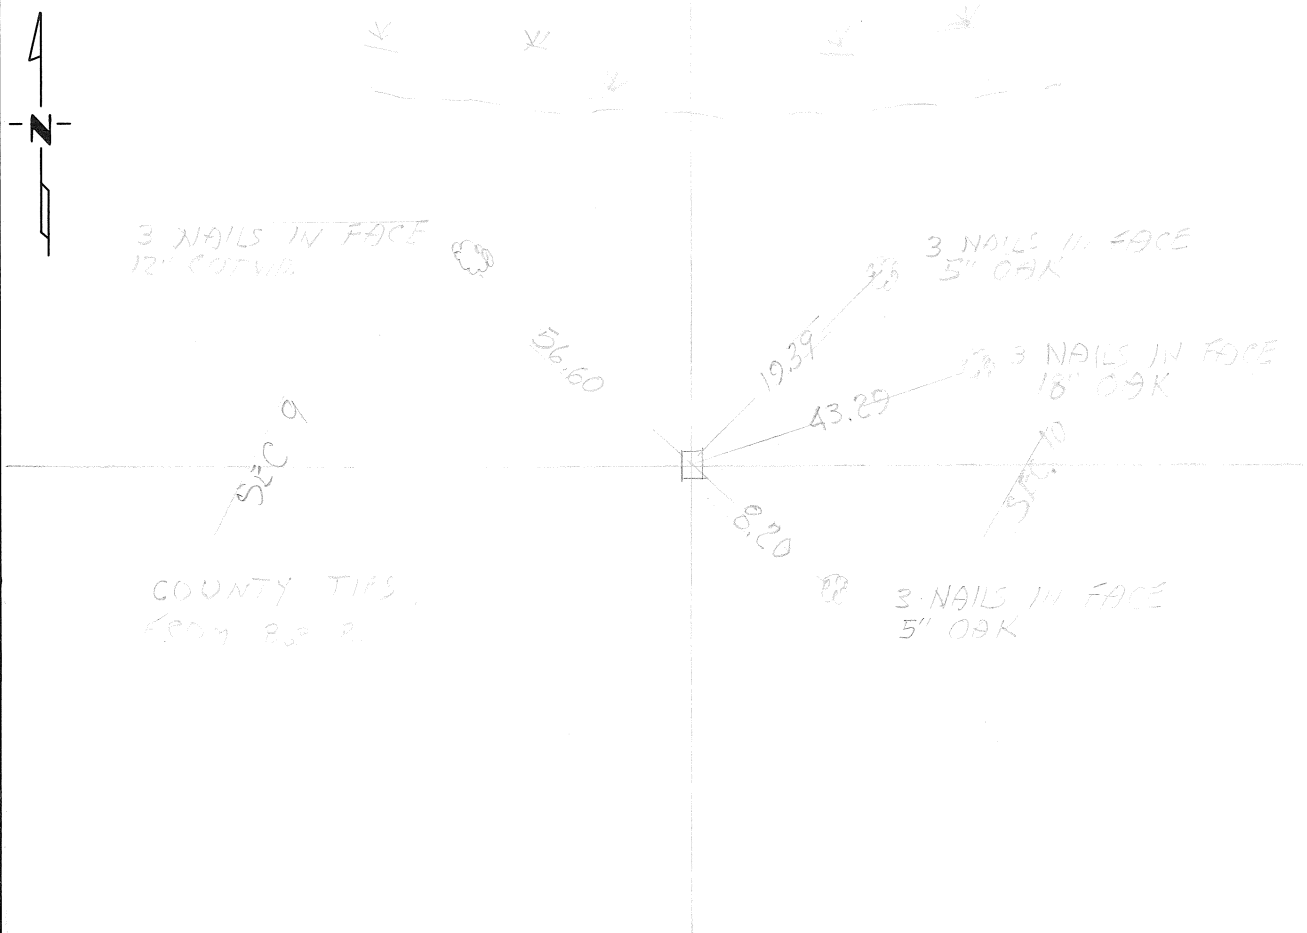

Statement of evidence relative to this corner location is on back of page.

I hereby certify that this document and the data contained herein was prepared by me or under my direct supervision.

\_\_\_\_\_  
SIGNATURE DATE

Registration No. \_\_\_\_\_

- Land Surveyor,  Professional Engineer
- County Surveyor,  County Engineer

OFFICE OF THE REGISTER OF DEEDS

County of \_\_\_\_\_

I hereby certify that this document was filed in the Reg. of Deeds office at \_\_\_\_\_ .M. on the \_\_\_\_\_ day of \_\_\_\_\_ A.D., 19 \_\_\_\_\_

Register of Deeds \_\_\_\_\_

By \_\_\_\_\_, Deputy

DOCUMENT NO. \_\_\_\_\_