

CERTIFICATE OF LOCATION OF GOVERNMENT CORNER


NORTH 500- Corner of Section 19, Township 30, Range 22, _____ P.M.

STATE OF MINNESOTA, County of RAVISTY

At the corner location shown on the sketch:

- On Feb 26 found a GRANITE MONUMENT
DATE
- left monument as found, lowered monument, removed monument (explain)
- On _____ placed a _____
DATE

SKETCH OF REFERENCE TIES

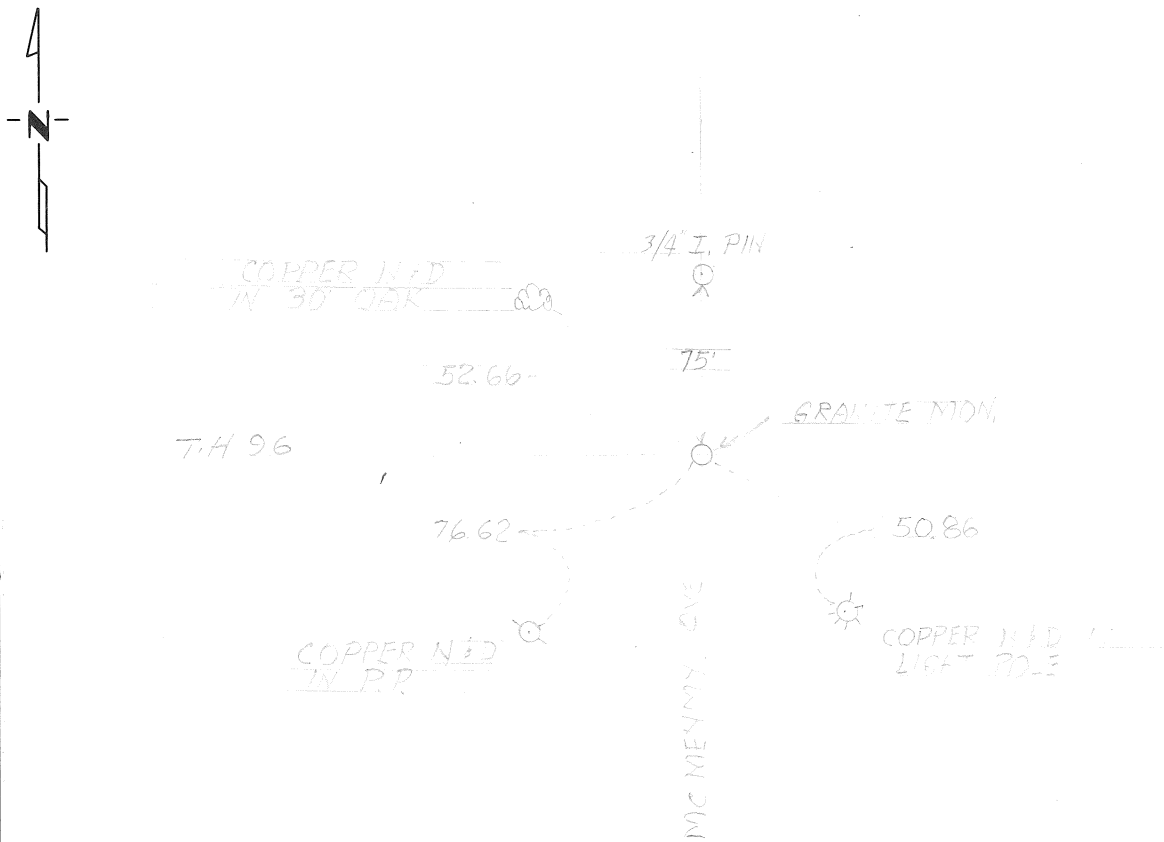

Statement of evidence relative to this corner location is on back of page.

I hereby certify that this document and the data contained herein was prepared by me or under my direct supervision.

SIGNATURE DATE

Registration No. _____

- Land Surveyor, Professional Engineer
- County Surveyor, County Engineer

OFFICE OF THE REGISTER OF DEEDS

County of _____

I hereby certify that this document was filed in the Reg. of Deeds office at _____ .M. on the _____ day of _____ A.D., 19 ____

Register of Deeds _____

By _____, Deputy

DOCUMENT NO. _____

Statement of Evidence:

SR 6224-17 T.H. 96 FEB 1967 S. FOX FOUND GRANITE INCLUDING
FLUSH WITH OLD CONCRETE PAVEMENT 6" TO 8" BELOW BIT OVERLAY.