

CERTIFICATE OF LOCATION OF GOVERNMENT CORNER

NORTH EAST Corner of Section 36, Township 30, Range 22, 4th P.M.

STATE OF MINNESOTA, County of RAMSEY


At the corner location shown on the sketch:

On 6-21-67 found a 1 1/2" I. PIN WITH PUNCH MARK
DATE

left monument as found, lowered monument, removed monument (explain)

On _____ placed a _____
DATE

SKETCH OF REFERENCE TIES

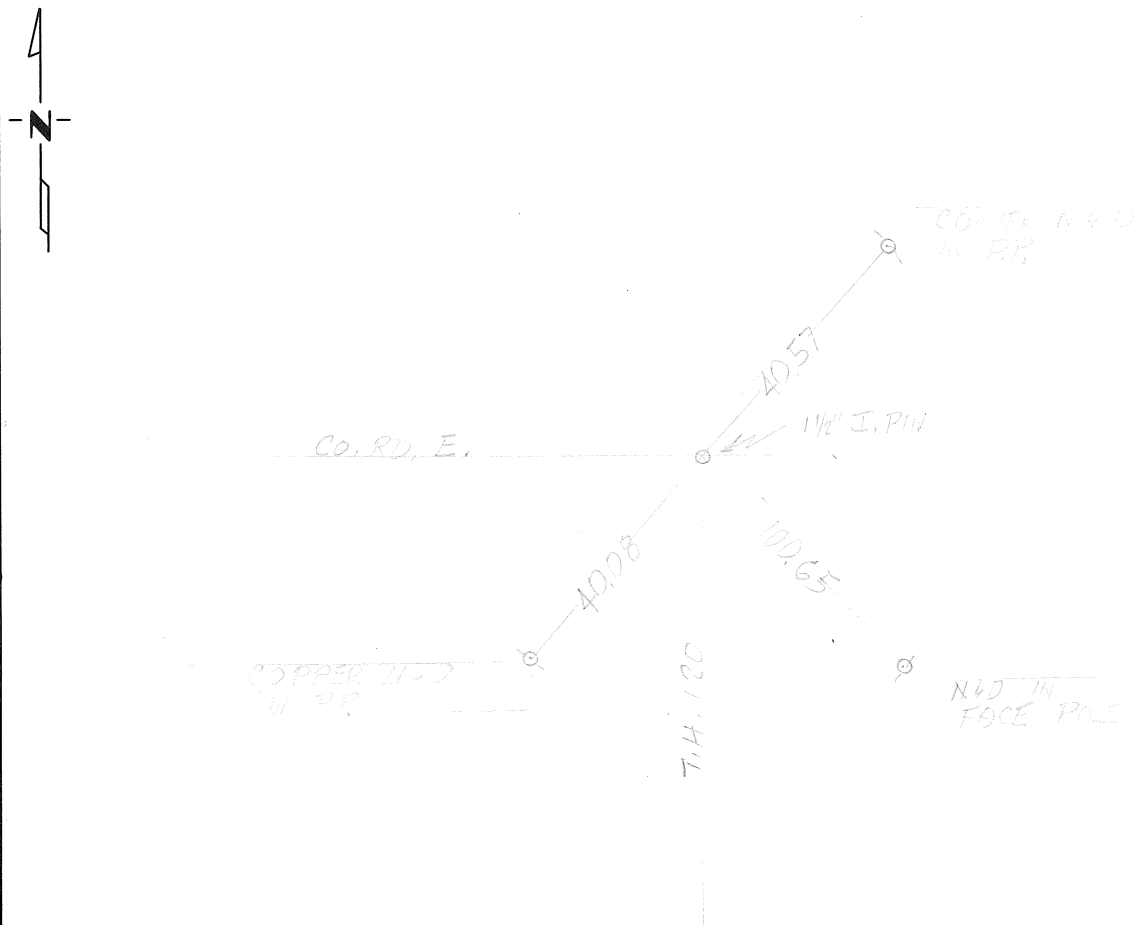

Statement of evidence relative to this corner location is on back of page.

I hereby certify that this document and the data contained herein was prepared by me or under my direct supervision.

SIGNATURE DATE

Registration No. _____

Land Surveyor, Professional Engineer

County Surveyor, County Engineer

OFFICE OF THE REGISTER OF DEEDS

County of _____

I hereby certify that this document was filed in the Reg. of Deeds office at _____ .M. on the _____ day of _____ A.D., 19 ____

Register of Deeds _____

By _____, Deputy

DOCUMENT NO. _____

Statement of Evidence:

'NOTE' PLUG MISSING IN 1/4" = 2" IN FROM TOP LEFT CORNER
BY B. LANE S.P. 6227-10