Index No. _____

CERTIFICATE OF LOCATION OF GOVERNMENT CORNER

NORTH EAST Corner of Section 6, Township 29, Range 23, ____ P.M.

STATE OF MINNESOTA, County of RAMSEY

At the corner location shown on the sketch:

☐ On 4-17-68 (DATE) found a ? TIES FROM VILLAGE SHOREVIEW, SECTION TIE BOOK

☐ left monument as found, ☐ lowered monument, ☐ removed monument (explain)

☐ On _____ (DATE) placed a _____

SKETCH OF REFERENCE TIES

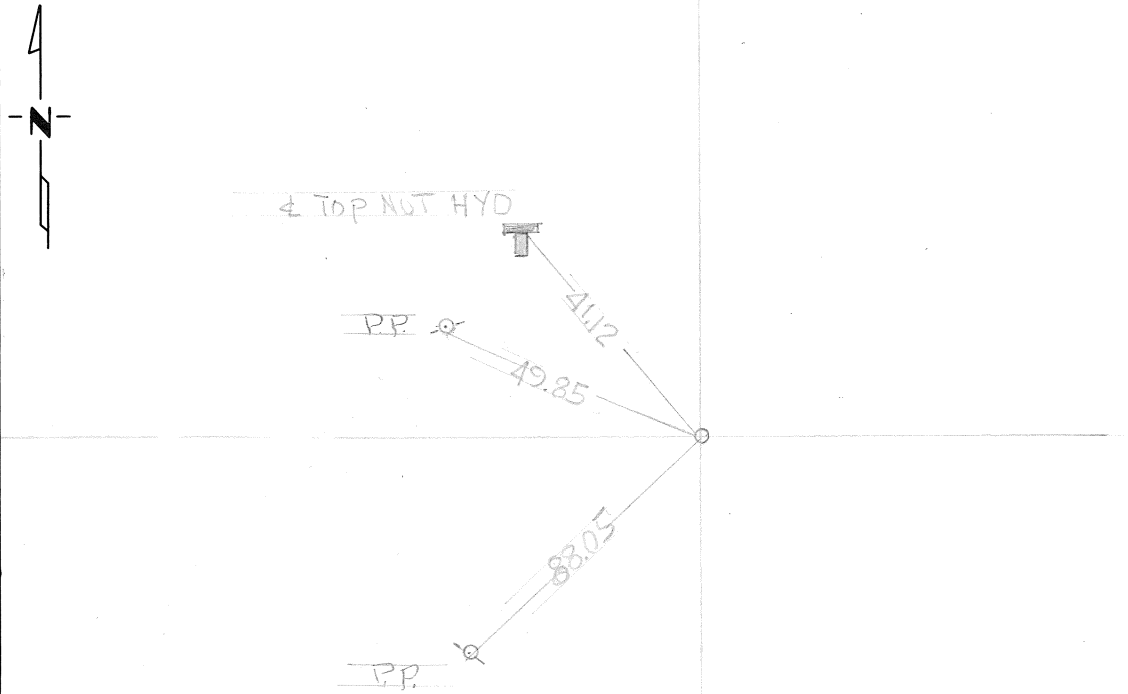

Statement of evidence relative to this corner location is on back of page.

I hereby certify that this document and the data contained herein was prepared by me or under my direct supervision.

_____ (SIGNATURE) _____ (DATE)

Registration No. _____

☐ Land Surveyor, ☐ Professional Engineer

☐ County Surveyor, ☐ County Engineer

OFFICE OF THE REGISTER OF DEEDS

County of _____

I hereby certify that this document was filed in the Reg. of Deeds office at _____ .M. on the _____ day of _____ A.D., 19 ___

Register of Deeds _____

By _____, Deputy

DOCUMENT NO. _____

M.H.D. FORM NO. 2105