Index No. _____

# CERTIFICATE OF LOCATION OF GOVERNMENT CORNER

NORTHEAST Corner of Section 13, Township 29N, Range 22W, 4th P.M.

STATE OF MINNESOTA, County of RAMSEY & WASHINGTON

At the corner location shown on the sketch:

☒ On SEPT 13,1973 (DATE) found a ½ in. iron pipe flush. Dug 1 ft. and found an 8 in. square granite monument directly beneath said pipe. ~~Replaced the iron pipe to its original position.~~

☒ left monument as found, ☐ lowered monument, ☐ removed monument (explain)

☐ On _____ (DATE) placed a _____

SKETCH OF REFERENCE TIES

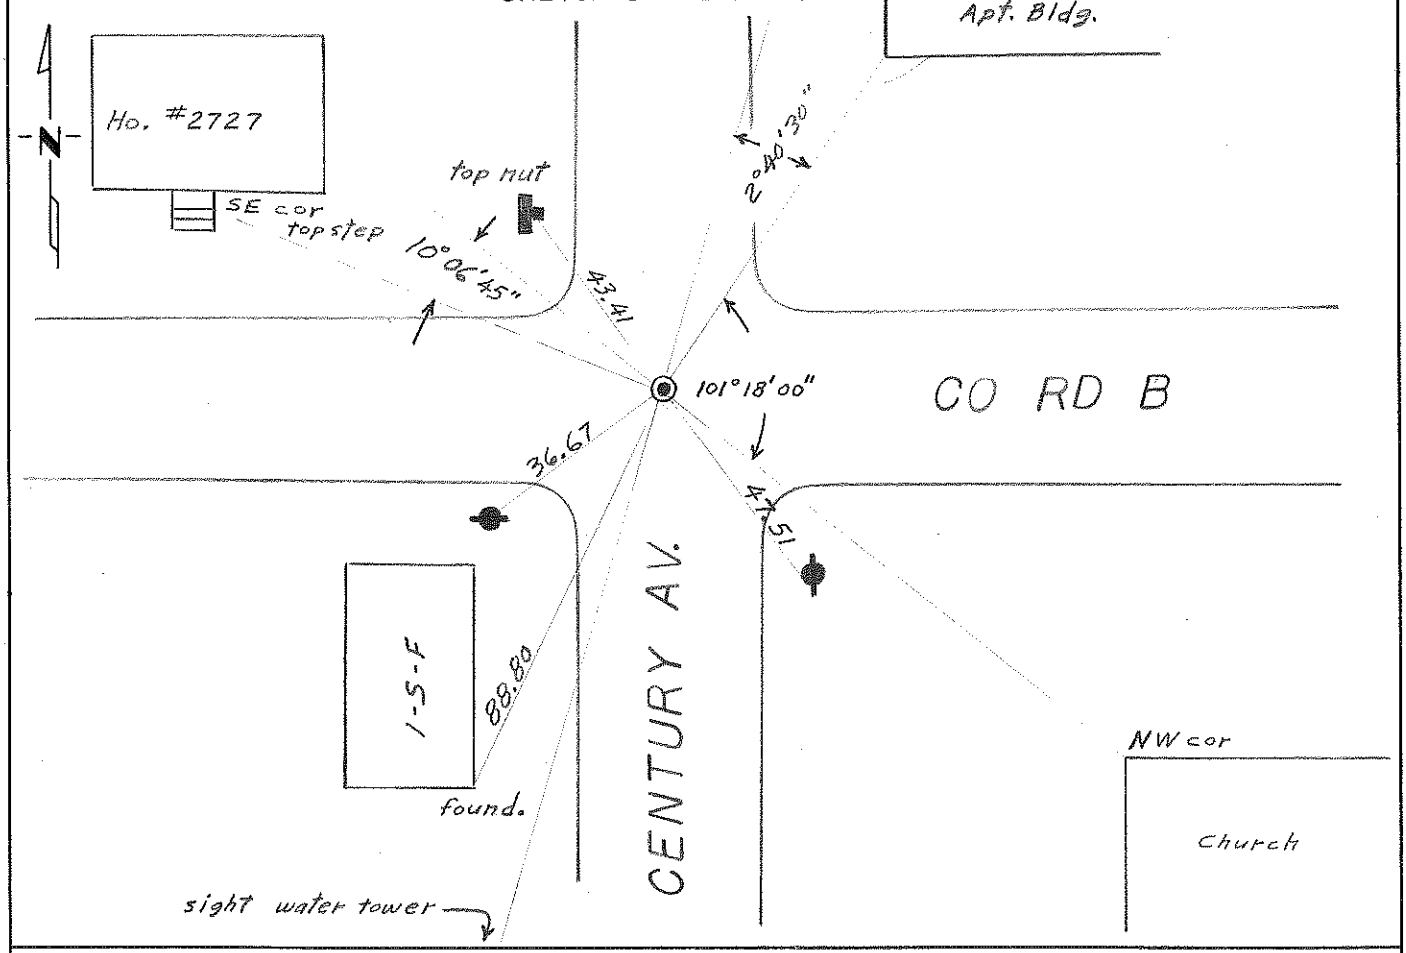


Statement of evidence relative to this corner location is on back of page.

I hereby certify that this document and the data contained herein was prepared by me or under my direct supervision.

_____ SIGNATURE _____ DATE

Registration No. _____

☐ Land Surveyor, ☐ Professional Engineer

☐ County Surveyor, ☐ County Engineer

OFFICE OF THE REGISTER OF DEEDS

County of _____

I hereby certify that this document was filed in the Reg. of Deeds office at _____ .M. on the _____ day of _____ A.D., 19 ___

Register of Deeds _____

By _____, Deputy

DOCUMENT NO. _____

M.H.D. FORM NO. 2105