


CERTIFICATE OF LOCATION OF GOVERNMENT CORNER

NORTH EAST Corner of Section 23, Township 29, Range 23, _____ P.M.
STATE OF MINNESOTA, County of RAMSEY

At the corner location shown on the sketch:

- On 4-16-68 found a TIES FROM VILLAGE ROSEVILLE SEC. TIE BOOK
DATE
- left monument as found, lowered monument, removed monument (explain)
- On _____ placed a _____
DATE

SKETCH OF REFERENCE TIES

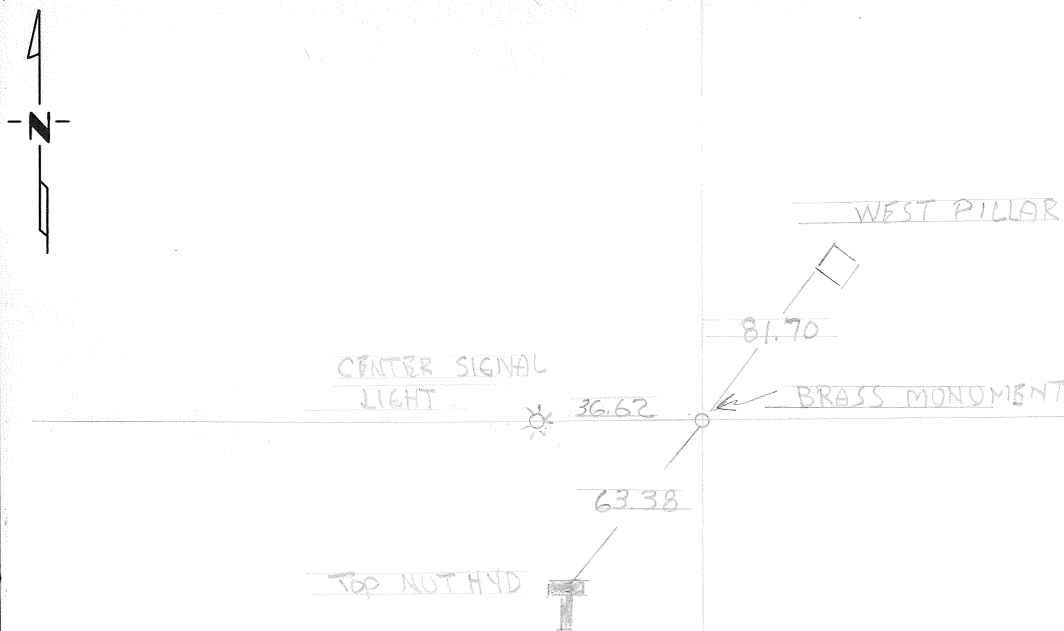

Statement of evidence relative to this corner location is on back of page.

I hereby certify that this document and the data contained herein was prepared by me or under my direct supervision.

SIGNATURE DATE

Registration No. _____

- Land Surveyor, Professional Engineer
- County Surveyor, County Engineer

OFFICE OF THE REGISTER OF DEEDS

County of _____

I hereby certify that this document was filed in the Reg. of Deeds office at _____ .M. on the _____ day of _____ A.D., 19 ____

Register of Deeds _____

By _____, Deputy

DOCUMENT NO. _____