


# CERTIFICATE OF LOCATION OF GOVERNMENT CORNER

NORTH EAST Corner of Section 24, Township 29, Range 23, \_\_\_\_\_ P.M.  
STATE OF MINNESOTA, County of RAMSEY

At the corner location shown on the sketch:

- On 4-16-68 found a TIES FROM VILLAGE OF ROSEVILLE SEC. TIE BOOK  
DATE
- left monument as found,  lowered monument,  removed monument (explain)
- On 6/78 placed a PK FROM 76 TIES, WILL SET CIM AT SAME POINT  
DATE SEE LATER DATA

## SKETCH OF REFERENCE TIES

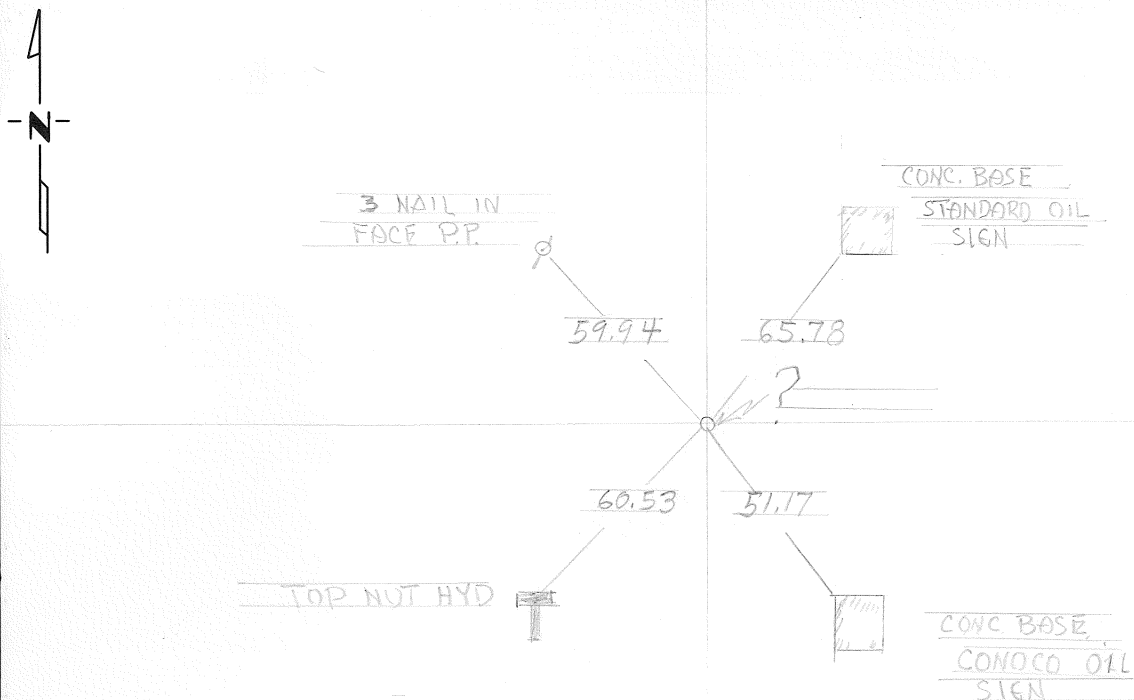

Statement of evidence relative to this corner location is on back of page.

I hereby certify that this document and the data contained herein was prepared by me or under my direct supervision.

\_\_\_\_\_  
SIGNATURE DATE

Registration No. \_\_\_\_\_

- Land Surveyor,  Professional Engineer
- County Surveyor,  County Engineer

### OFFICE OF THE REGISTER OF DEEDS

County of \_\_\_\_\_

I hereby certify that this document was filed in the Reg. of Deeds office at \_\_\_\_\_ .M. on the \_\_\_\_\_ day of \_\_\_\_\_ A.D., 19 \_\_\_\_

Register of Deeds \_\_\_\_\_

By \_\_\_\_\_, Deputy

DOCUMENT NO. \_\_\_\_\_