

CERTIFICATE OF LOCATION OF GOVERNMENT CORNER

Corner to Sec. 4.5.8.9 T. 30N R. 23W.

State of Minnesota }
County of Ramsey } ss.

I hereby certify that on The 14th day of September 1927

I found the Section Corner

which was evidenced by an Iron Pipe

and I further certify that to perpetuate the location of such corner I did at the exact location thereof place a permanent marker consisting of a Brass Plug set in Concrete Pavement

I further certify that I established Two

reference or witness monuments consisting of X on 6" x 6" x 30" Concrete Monument

which reference or witness monuments are located in the manner following:

North 58° 30' West a Distance of 56.50 ft

South 55° 41' West a Distance of 57.00 ft.

Brass Plug set in Center of 27 ft Concrete Pavement S.P. 63-022 Div C

Engineers Station 318 + 58.8

Dated at St Paul Minn., this 21st day of February 1929

St Johnston

Sub Resident Engineer

Minn State Highway Commission

OFFICE OF REGISTER OF DEEDS }
County of } ss.

I hereby certify that the within instrument was filed in this office for record on the

day of A. D. 19 at o'clock M.

Register of Deeds

By Deputy

Filed for record on the 5 day of Mar. A.D. 1929, at 1:40 o'clock P.M.

CERTIFICATE OF LOCATION OF GOVERNMENT CORNER


North East Corner of Section 8, Township 30, Range 23, 4th P.M.

STATE OF MINNESOTA, County of Ramsey

At the corner location shown on the sketch:

- On _____ found a _____
DATE
- left monument as found, lowered monument, removed monument (explain)
- On 18 Dec. 73 placed a Iron Pin With Brass Cap In Slope Paving
DATE
Under Bridge.

SKETCH OF REFERENCE TIES

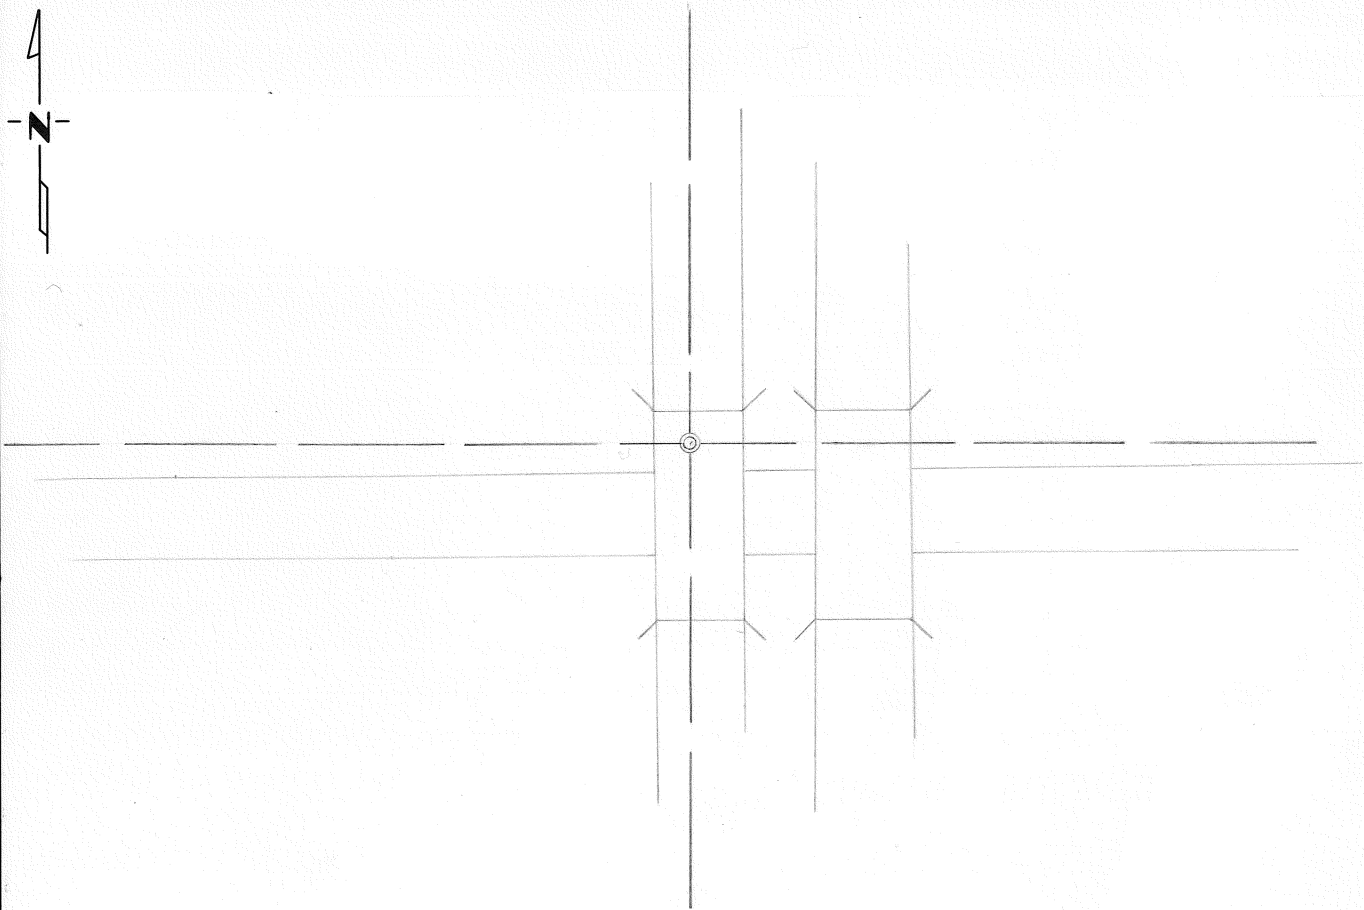

Statement of evidence relative to this corner location is on back of page.

I hereby certify that this document and the data contained herein was prepared by me or under my direct supervision.

SIGNATURE DATE

Registration No. _____

- Land Surveyor, Professional Engineer
- County Surveyor, County Engineer

OFFICE OF THE REGISTER OF DEEDS

County of _____

I hereby certify that this document was filed in the Reg. of Deeds office at _____ .M. on the _____ day of _____ A.D., 19 _____

Register of Deeds _____

By _____, Deputy

DOCUMENT NO. _____