22 29 36

Index No. _____

CERTIFICATE OF LOCATION OF GOVERNMENT CORNER

East quarter Corner of Section 36, Township 29N, Range 22W, 4th P.M.

STATE OF MINNESOTA, County of Ramsey and Washington

At the corner location shown on the sketch:

☒ On Mar 4, 1974 (DATE) found a 8 in. by 8 in. granite monument 7 in. below the bituminous surface.

☒ left monument as found, ☐ lowered monument, ☐ removed monument (explain)

☐ On _____ (DATE) placed a _____

SKETCH OF REFERENCE TIES

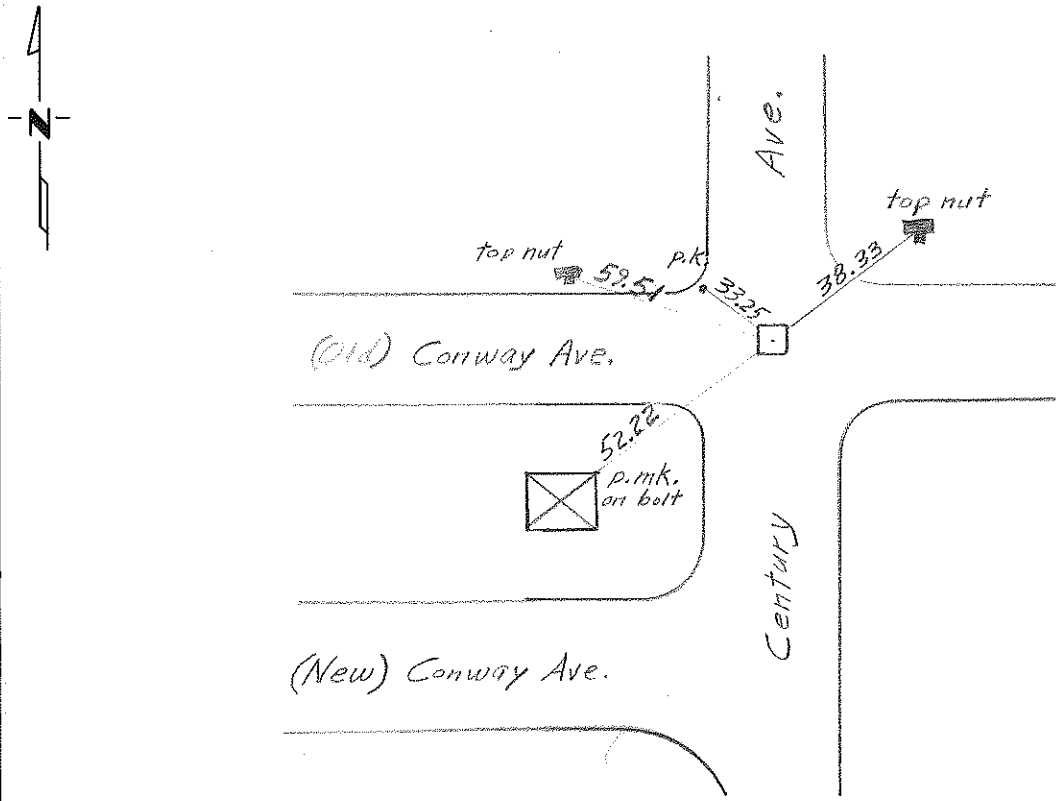

Statement of evidence relative to this corner location is on back of page.

I hereby certify that this document and the data contained herein was prepared by me or under my direct supervision.

_____ SIGNATURE _____ DATE

Registration No. _____

☐ Land Surveyor, ☐ Professional Engineer

☐ County Surveyor, ☐ County Engineer

OFFICE OF THE REGISTER OF DEEDS

County of _____

I hereby certify that this document was filed in the Reg. of Deeds office at _____ .M. on the _____ day of _____ A.D., 19 ___

Register of Deeds _____

By _____, Deputy

DOCUMENT NO. _____

M.H.D. FORM NO. 2105