

CERTIFICATE OF LOCATION OF GOVERNMENT CORNER

~~E 1/4 COR 5~~  
N.E. COR. 5

Corner to Sec. 4 & 5 T. 30 N R. 23 W

State of Minnesota }  
County of Anoka & Ramsey } ss.

I hereby certify that on The 10th day of July 1928.

I found the Section Corner on Anoka & Ramsey County Line

which was evidenced by an 8" X 8" Square Stone Monument

and I further certify that to perpetuate the location of such corner I did at the exact location thereof place a permanent marker consisting of a Brass Plug Set in Concrete Pavement

I further certify that I established Two reference or witness monuments consisting of a X on 6" X 6" X 30" Concrete Monument

which reference or witness monuments are located in the manner following:

North 52°32' East a Distance of 53.70 Ft

South 46°39' East a Distance of 57.55 Ft

Brass Plug Set in Concrete Pavement on Curve 51.5 Ft North of P.C.

S.P. 63-022 Div C Engineers Station 378+02.2

Dated at St Paul Minn., this 21st day of February 1929.

J.H. Johnston

Sub Resident Engineer

Minn State Highway Commission

OFFICE OF REGISTER OF DEEDS }  
County of } ss.

I hereby certify that the within instrument was filed in this office for record on the

day of A. D. 19 at o'clock M.

Register of Deeds

By Deputy

Filed for record on the 5 day of Mar. A.D. 1929, at 1:40 o'clock P.M.

# CERTIFICATE OF LOCATION OF GOVERNMENT CORNER


North East Corner of Section 5, Township 30, Range 23, 4th P.M.

STATE OF MINNESOTA, County of Ramsey

At the corner location shown on the sketch:

- On \_\_\_\_\_ found a \_\_\_\_\_  
DATE
- left monument as found,  lowered monument,  removed monument (explain)
- On Dec. 73 placed a Brass Plug  
DATE

## SKETCH OF REFERENCE TIES

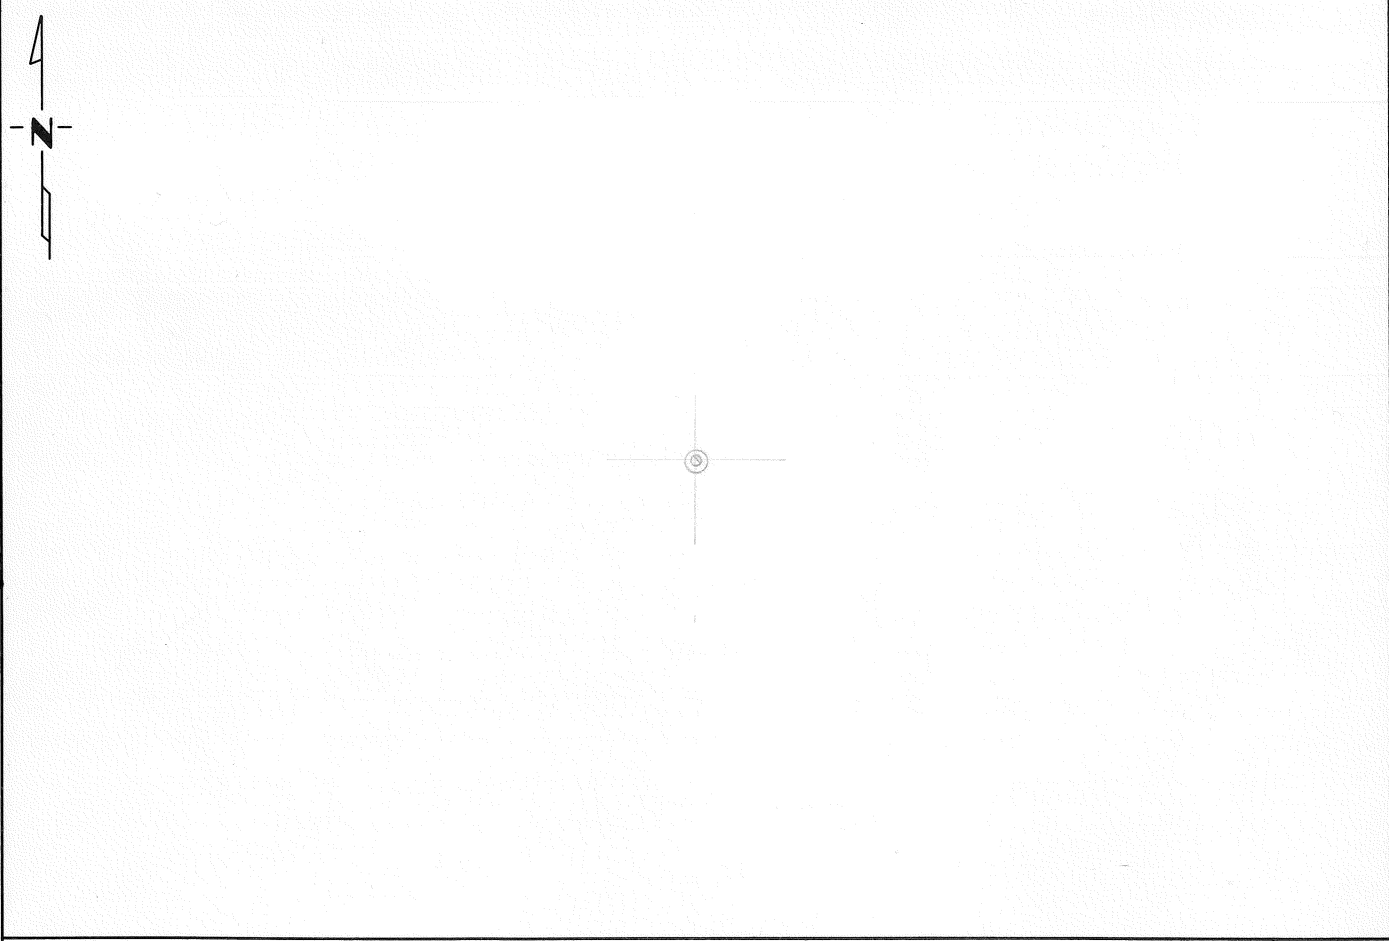

Statement of evidence relative to this corner location is on back of page.

I hereby certify that this document and the data contained herein was prepared by me or under my direct supervision.

\_\_\_\_\_  
SIGNATURE DATE

Registration No. \_\_\_\_\_

- Land Surveyor,  Professional Engineer
- County Surveyor,  County Engineer

OFFICE OF THE REGISTER OF DEEDS  
County of \_\_\_\_\_

I hereby certify that this document was filed in the Reg. of Deeds office at \_\_\_\_\_ .M. on the \_\_\_\_\_ day of \_\_\_\_\_ A.D., 19 \_\_\_\_

Register of Deeds \_\_\_\_\_

By \_\_\_\_\_, Deputy

DOCUMENT NO. \_\_\_\_\_