Bldg

SEC. 1 TWP. 30 RGE. 23

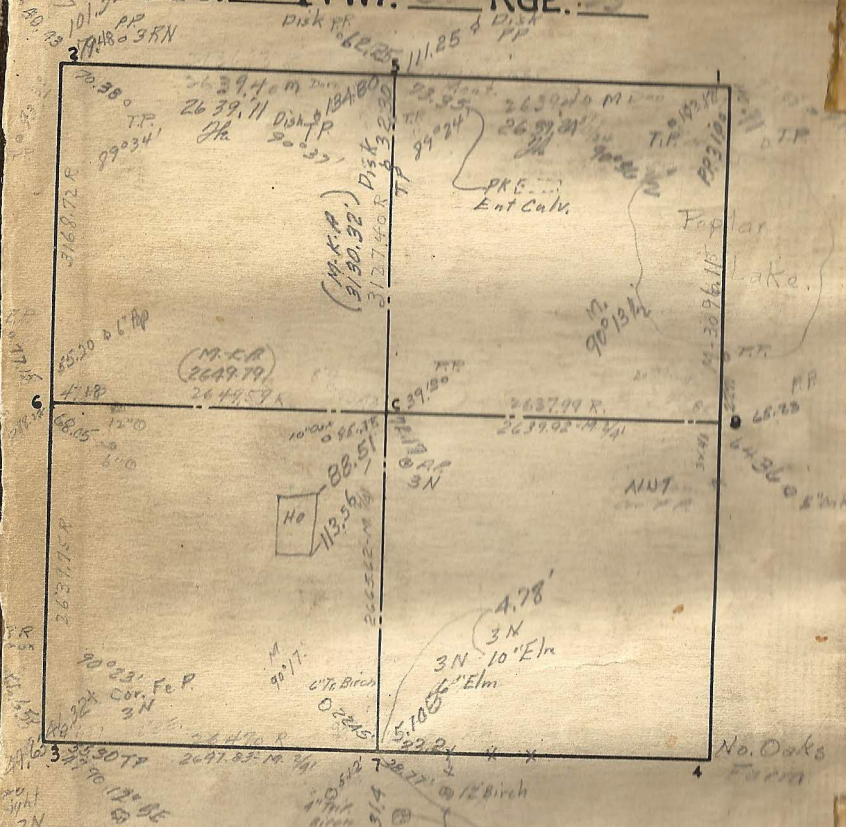

Cor.	Remarks
#1	Found Iron 3-1-34

Iron	1	OK 12/43 1/4L 11/50 3/52 4/65
	2	OK 12/43 1/4L 3/52
	3	OK 12/43 1/4L 3/52 2/54
	4	
Sandstone Down 3'	5	OK 12/43 1/4L 11/50 3/52 10/65
	6	OK 12/43 1/4L 3/52
Granite No Hole	7	Tipped 1/4L 1/65 9/71
	8	OK 12/43 3/52
Granite	C	1/4L 3/52 9/71