SEC. 2 TWP. 30 RGE. 28

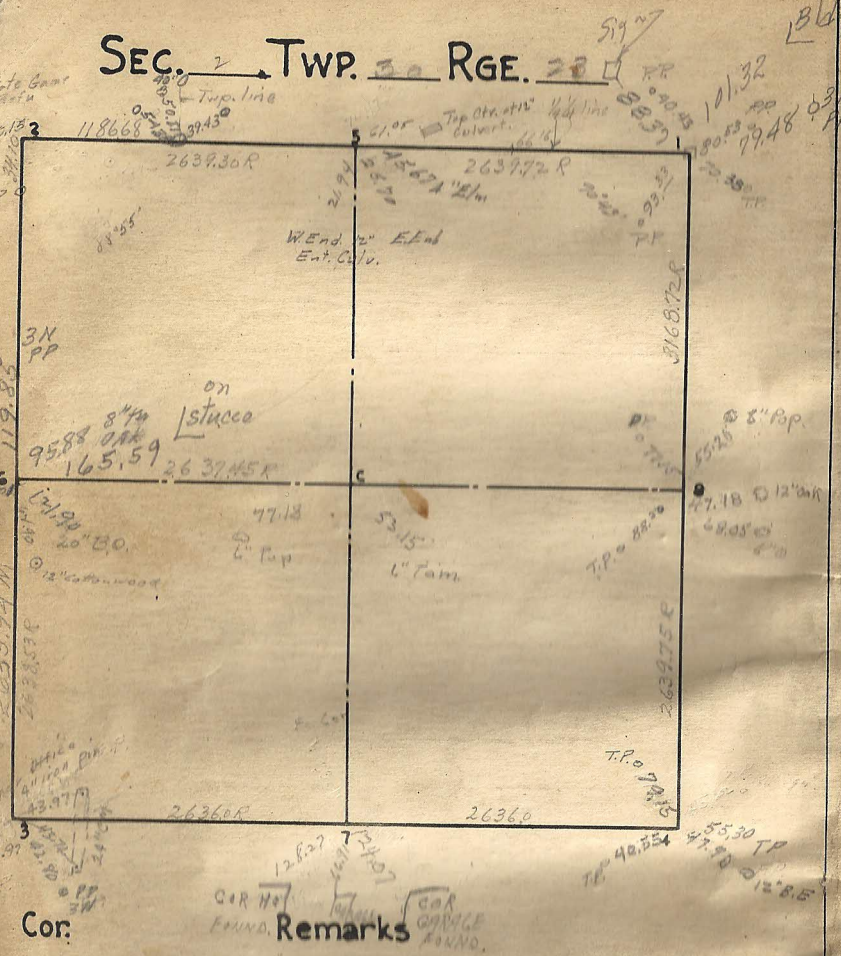

Granite 1 OK 12/43 1/4L 11/50 3/5n 10/65

2 OK 12/43 1/4L 3/5n Tipped New Ties & Bolts 50 Mont. in Ne Ditch 70'E 2/54 FK

Granite 3 3/68 3/5n OK 3/54 Ptnts 4/61 R76

4 OK 12/43 1/4L 3/5n 3/54

5 OK 12/43 1/4L 11/50 3/5n

6 OK 12/43 1/4L 3/5n

7 OK 12/43 1/4L 3/5n

8 OK 12/43 1/4L 3/5n

C Est 3/23/42 Iron Pipe

1.93

8" Pipe Ditch 1/4" Pipe

8.09 8.18

3N 3N 3N 3N

5 Tie 5 Tie 3"CE 5 Tie 6"CE 5 Tie

6"CE Tn