


SEC. 3 TWP. 30 RGE. 23

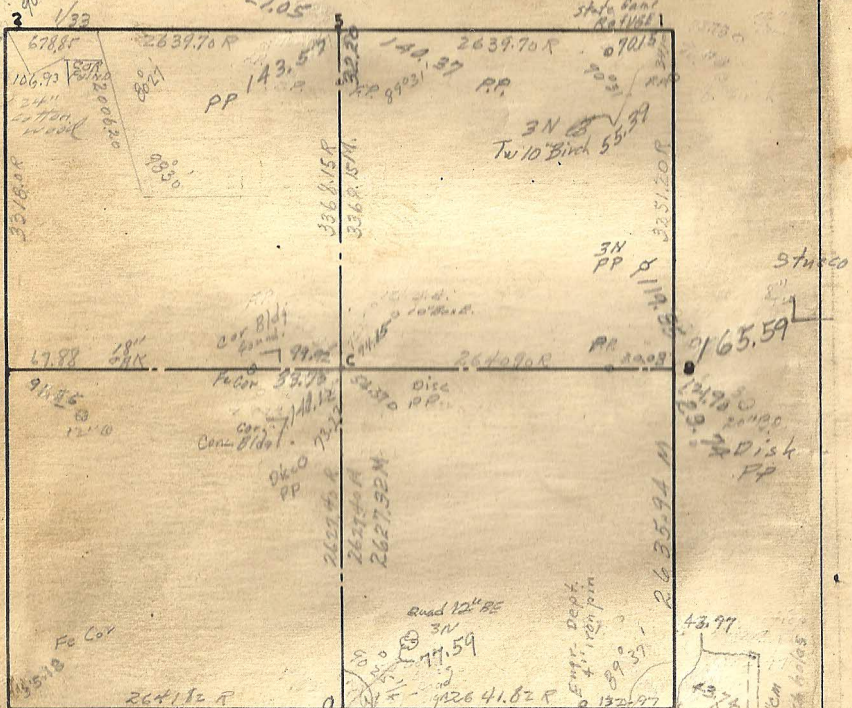

Cor:

Remarks

- 5- Down 20" $\frac{3}{38}$
- C Down 3" $\frac{3}{38}$
- 1 Raised 7-12-38

Mont 1 $\frac{OK}{1/46}$ $\frac{3/52}{1/46}$ Tipped New ties to Post Spk $\frac{2/54}{1/46}$ FX

Iron over Granite 2 $\frac{OK}{1/43}$ $\frac{1/46}{1/46}$ $\frac{1/50}{1/50}$ $\frac{2/54}{2/54}$ $\frac{10/63}{10/63}$

3 $\frac{OK}{1/43}$ $\frac{1/47}{1/47}$ $\frac{OK}{1/50}$ $\frac{3/54}{3/54}$

Granite 4 $\frac{3/68}{3/68}$ $\frac{1/46}{1/46}$ $\frac{1/50}{1/50}$ $\frac{2/54}{2/54}$ $\frac{10/63}{10/63}$ $\frac{4/61}{4/61}$ $\frac{2/54}{2/54}$

5 $\frac{OK}{1/43}$ $\frac{1/46}{1/46}$ $\frac{3/52}{3/52}$ $\frac{10/63}{10/63}$

6 $\frac{OK}{1/43}$ $\frac{1/46}{1/46}$ $\frac{1/50}{1/50}$ $\frac{3/54}{3/54}$

Iron Over Granite 7 $\frac{1/46}{1/46}$ $\frac{1/50}{1/50}$ $\frac{2/54}{2/54}$ $\frac{10/63}{10/63}$ $\frac{4/61}{4/61}$ $\frac{2/54}{2/54}$

8 $\frac{OK}{1/43}$ $\frac{1/46}{1/46}$ $\frac{3/52}{3/52}$

C $\frac{OK}{1/43}$ $\frac{1/46}{1/46}$ $\frac{3/52}{3/52}$ $\frac{2/54}{2/54}$