


SEC. 4 TWP. 30 RGE. 23

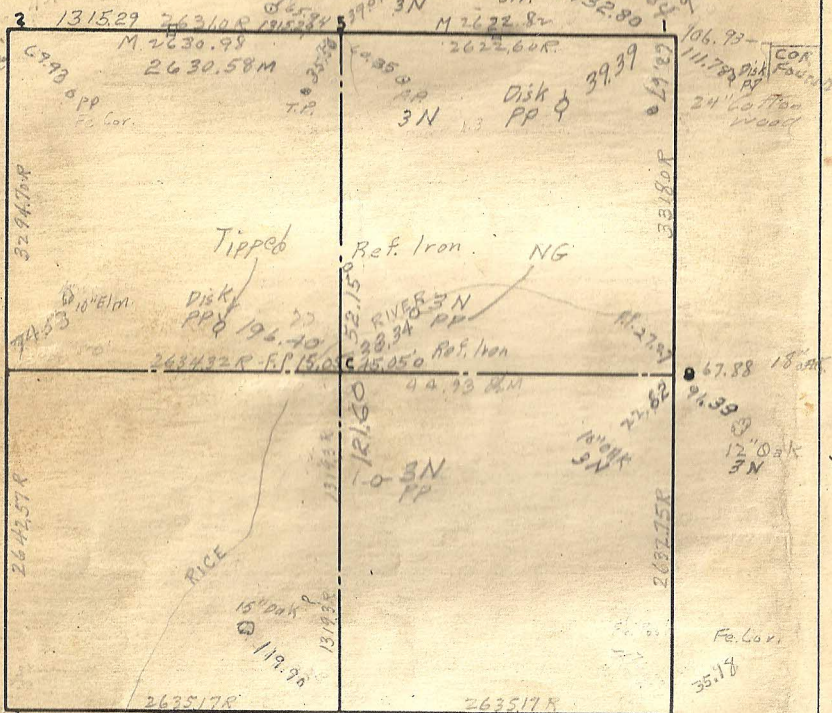

Cor:

4th Gate Post
West of West
Gate Post

Remarks

East Gate Post

20.84
