SEC. 5 TWP. ___ RGE. ___

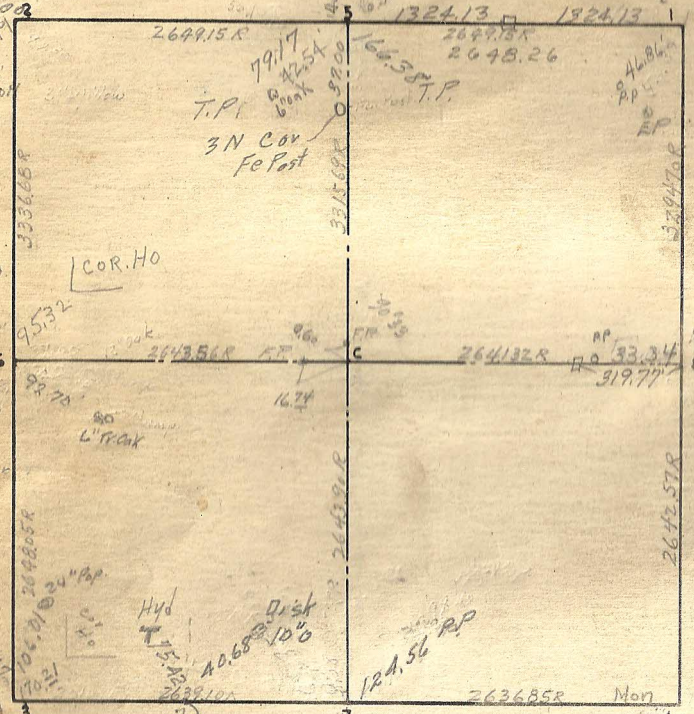

Cor.	Remarks
5	Relted 6-23-12

Iron Over Granite	1	OK 12/43 1/46 11/50 3/52 10/65
	2	OK 11/43 1/46 11/50 3/52
	3	OK 1/43 1/46 11/50 3/52 4/65 (Turn Page)
	4	OK 12/43 1/46 Local 11/50 3/52 2/54
Iron over Stone	5	OK 12/43 1/46 3/52 DOWN 0.70 3/52 10/65 7/68
	6	OK 11/43 1/46 11/50 3/52
	7	New Ties 1/46 11/50 3/52 See Sec. 8
	8	OK 12/43 1/46 11/50 3/52
Granite	C	Rest 10/43 HW Notes 1/46 11/50 3/52 1/74