SEC. 6 TWP. RGE.

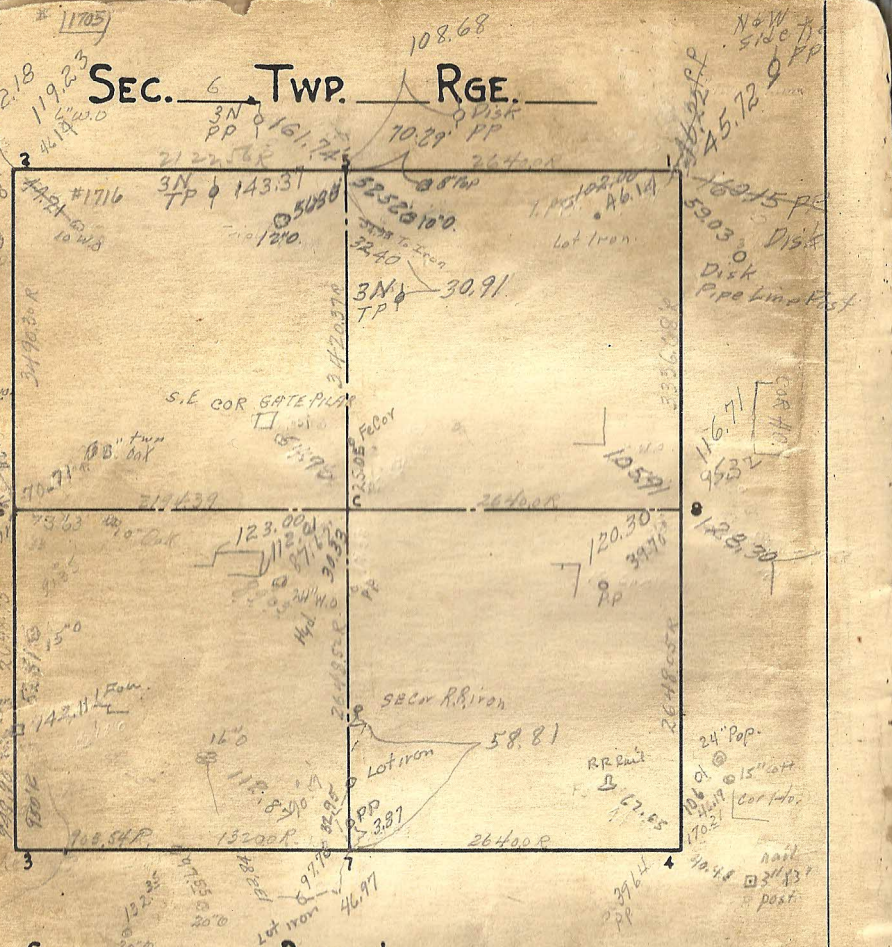

Cor.	Remarks
M.C.	Sline S.W. 1/4 - Out - 1/46 11/50
M.C.	E. of S.W. Cor. Placed Iron using old Ties 6-13-40 - R.A.
M.C.	N. of S.W. Cor. New ties 2/54

Granite	1	91°00'	1/46	11/50	3/52	Down 7" New Ties 2/54	4/74
Granite	2	OK 11/43	1/46	11/50	3/52	10/65	
	3	In Lake					
	4	90°55'	1/46	11/50	3/52	4/65	
Iron in Conc	5	~~IRON~~ 11/50	11/50	3/51	2/54	3/68	
	6	OK 11/40	1/46	11/50	3/52	Lot Iron 100	
	7	OK 12/43	11/50	3/52	11/53		
	8	SW = 89°04½ NW = 90°56'	1/46	11/50	3/52	P.K. 99.55	99.25 P.K.
C.I. Mont.	C	OK 10/43	1/46	11/50	3/52	3/54	12/66

Flag Pole 78.86 21.58 Hyd

97.43 MC N of SW Cor