SEC. 7 TWP. ____ RGE. ____

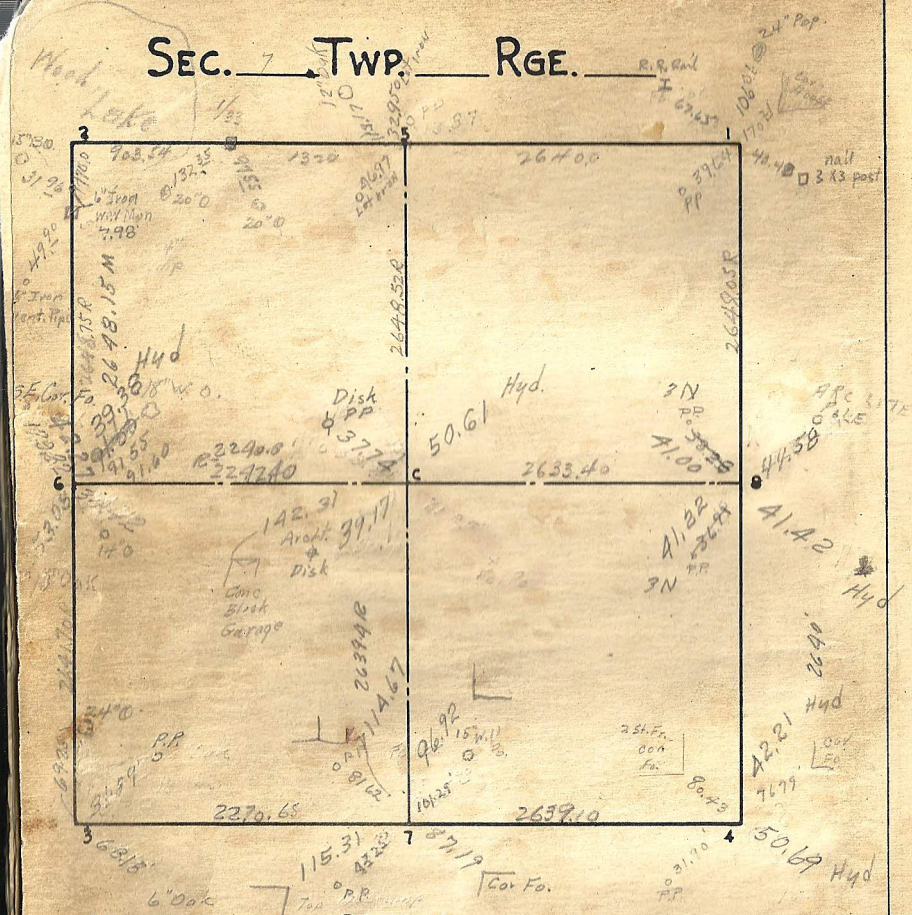

Cor.	Remarks
M.C.	N Line N.W. ¼ out.
5	Retied 6-25-42 OK 11/43
M.C.	W. Line Ties But Could not Find Mont 2/54

1 89° 07¾ 1/46 3/52 4/65

2 in Lake MC on N+S Line OK 1/46

3 OK 10/43 OK/53

P.K. nail 4 OK 10/43 3/53 1/65 12/66

5 OK 11/43 1/46 (O.K. 6-49) OK 11/53 118.56 N.

6 OK 10/43 Raise 1/46 New Ties 11/53 4/67

7 OK 10/43 3/53 OK 2/61

8 OK 11/43 1/46 2/54 12/64 89.21 3 M Tw 90°0

Iron → 134.75 Top stone

Cl Mon C 2/67

Bottle pp Cop Side tie

Found stone W.M.C. 54.40 45.59 49

19.21 Ct. M.H.

Vent Pipe

Hyd. 90.64